

Name

Service No.

Address # 15 Dewey Road

# 15 Dewey Lot 6

Lot 6

Location

Kind of Pipe

Size

Size of Main

Repair—Renewal—New Service

Location

Date	Material	Amount	Total	Date	Amount
Oct. '67	21' 6" Transite pipe@ 6.50		136.50		
				10 - 67	
				21' 6" Transite	


DATE \_\_\_\_\_

TOWN OF LEXINGTON — BOARD OF PUBLIC WORKS

SEWER DIVISION

Sketch of Service Here

15

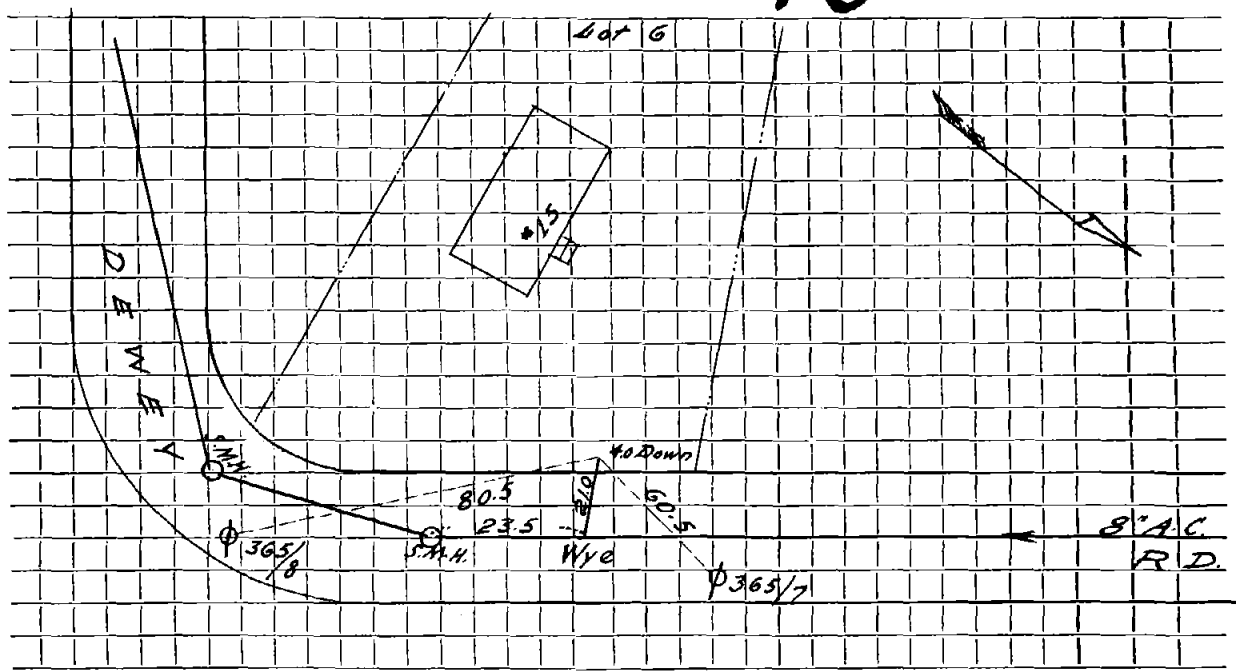

Connection made in ..... Street. Work completed .....

Remarks: .....  
.....  
.....