

Name

Service No.

Address # 18 Dewey Road

Lot 31

Location

Kind of Pipe

Size

Size of Main

Repair—Renewal—New Service


Location

Date		Material	Amount	Total	Date	Amount
Oct. 16	171	6" Transite pipe @	6.50	110.50		
					10- - 67	
					17' 6" Transite	

DATE _____

TOWN OF LEXINGTON — BOARD OF PUBLIC WORKS
SEWER DIVISION

Sketch of Service Here **18**

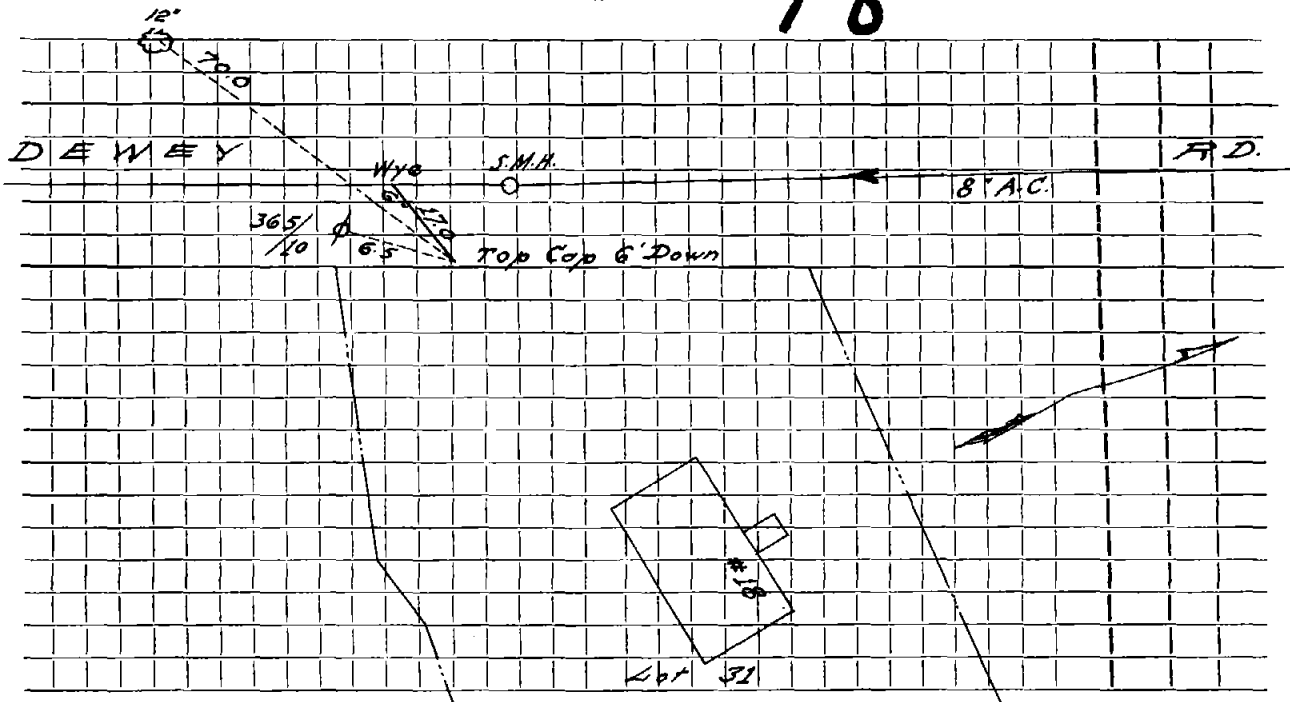

Connection made in Street. Work completed

Remarks:
.....
.....