

Name Ravinder Sakhija

Service No. 12

Address #2 Dewey Rd.

Location

Kind of Pipe A.C.

Size 6"

Size of Main 8"

~~Repair/Replacement~~ New Service Suburbanite #3484

Location JUN 23 1980


| Date | Material | Amount | Total | Date | Amount |
|---------|--|----------|----------|--------|---------------|
| 11/8/69 | (Sewer betterment abated) charge in lieu of betterment when lateral is provided will be | \$923.62 | | 5-2-80 | Deposit 30.00 |
| 4/28/75 | 3' A.C. @ \$10.00 | + 30.00 | \$953.62 | | |
| 6-4-80 | 55' 6" Transite pipe | | | | |
| | 22' 4" Cast Iron pipe | | | | |

DATE _____

TOWN OF LEXINGTON — BOARD OF PUBLIC WORKS

SEWER DIVISION

Sketch of Service Here **2**

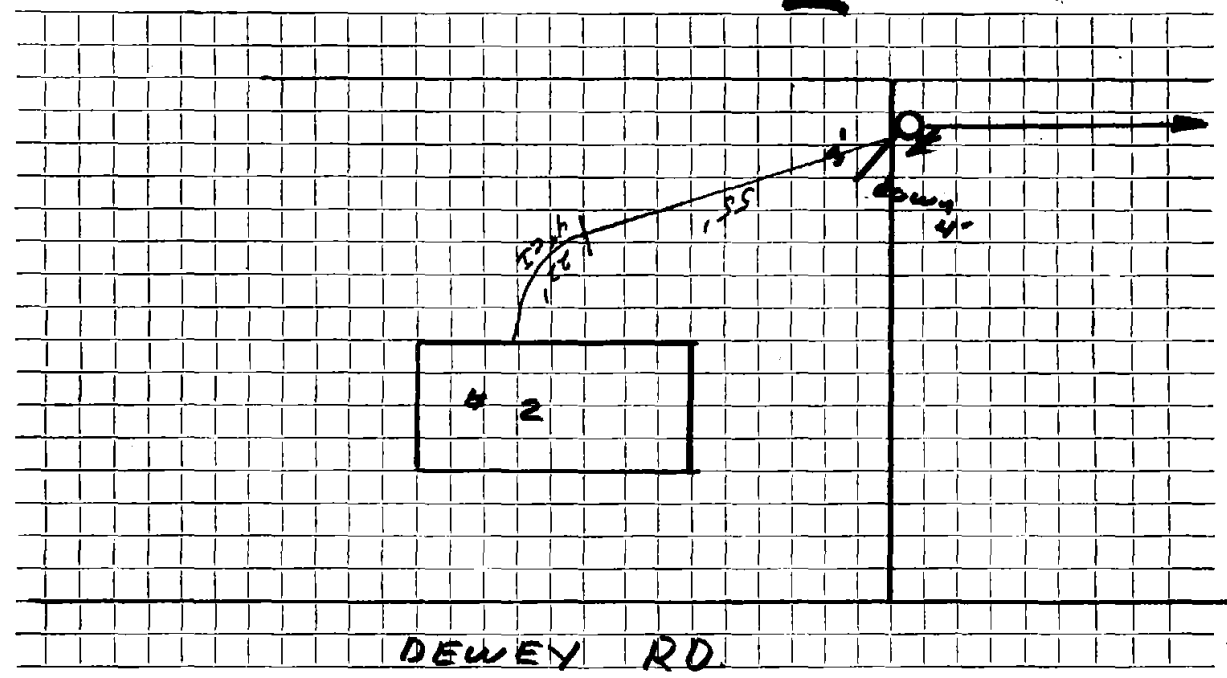

Connection made in Street. Work completed

Remarks:
.....
.....

Name

Service No.

Address # 2 Dewey Road

Lot 14

Location

Kind of Pipe

Size

Size of Main

Repair—Renewal—New Service

Location

Date

Material

Amount

Total

Date

Amount

Oct. '67 21'

6" Transite pipe@6.50


136.50

DATE _____

TOWN OF LEXINGTON — BOARD OF PUBLIC WORKS

SEWER DIVISION

Sketch of Service Here

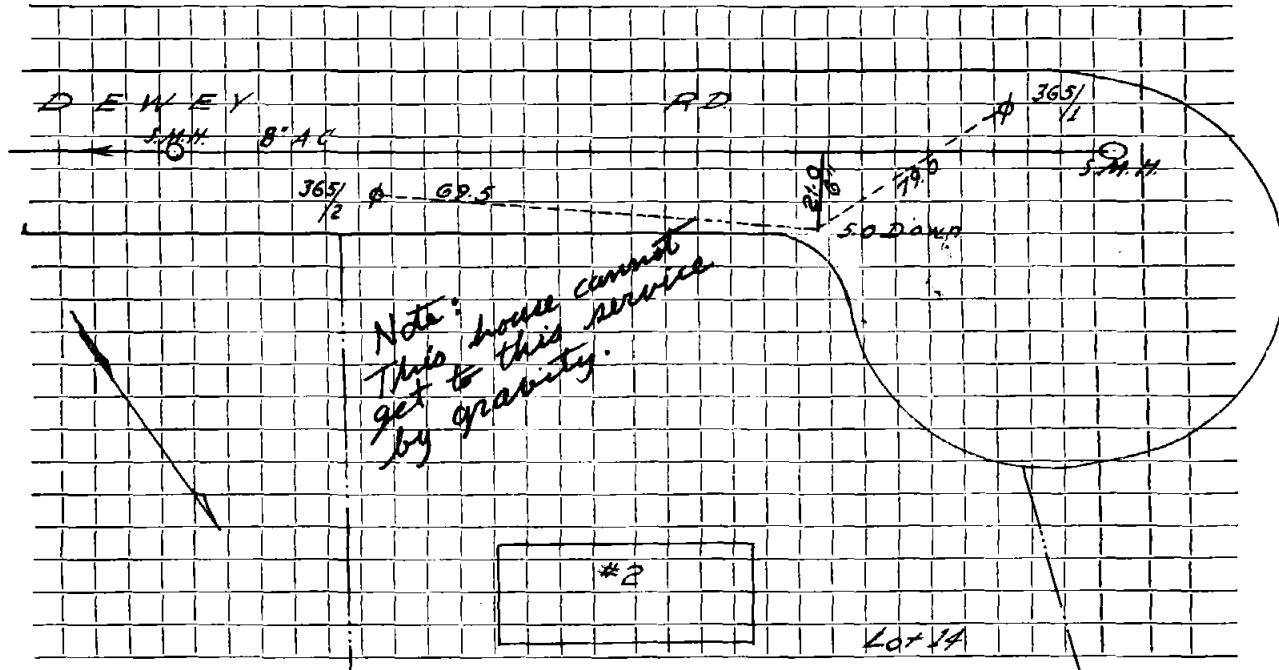

Connection made in Street. Work completed

Remarks:
.....
.....