

Name Dorothy Yagoda

Service No. 125

Address # 20 Dewey Road

Lot 30

Location

Kind of Pipe

Size

Size of Main

Repair—Renewal—New Service Lexington Sewerage #1503

Location MAR 30 1970

Date	Material	Amount	Total	Date	Amount	
Oct. '67 17'	6" Transite pipe @ 6.50	6.50	110.50	10-27-69	<i>Deposit</i>	<i>110 50</i>
11-14-69 48'	6" Transite pipe					
15'	4" Cast Iron pipe					
				10- - 67		
				17'	6" Transite	


DATE _____

TOWN OF LEXINGTON — BOARD OF PUBLIC WORKS

SEWER DIVISION

Sketch of Service Here

20

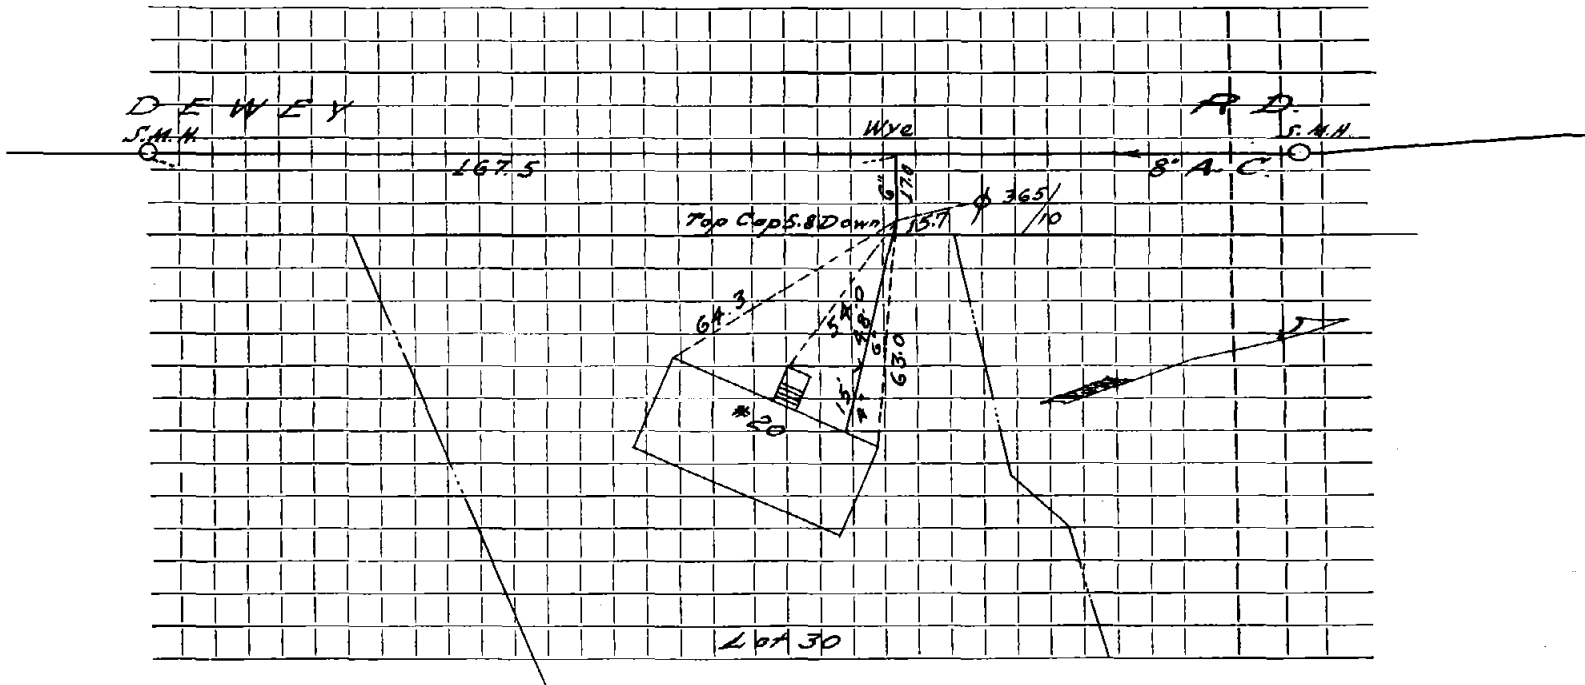

Connection made in Street. Work completed

Remarks:

.....
.....