

Name Gerald D. Shirley

Service No.

Address 22 Dewey Road

Lot 44

Location

Kind of Pipe

Size

Size of Main

~~Repair Report~~ **New Service** J.M. Lucente Permit #31

Location


Date	Material	Amount	Total	Date	Amount
uly '64	45' 6" Transite pipe				
4-65	57' 6" Transite pipe installed by John Devine Permit #207				

DATE _____

TOWN OF LEXINGTON — BOARD OF PUBLIC WORKS

SEWER DIVISION

Sketch of Service Here **22**

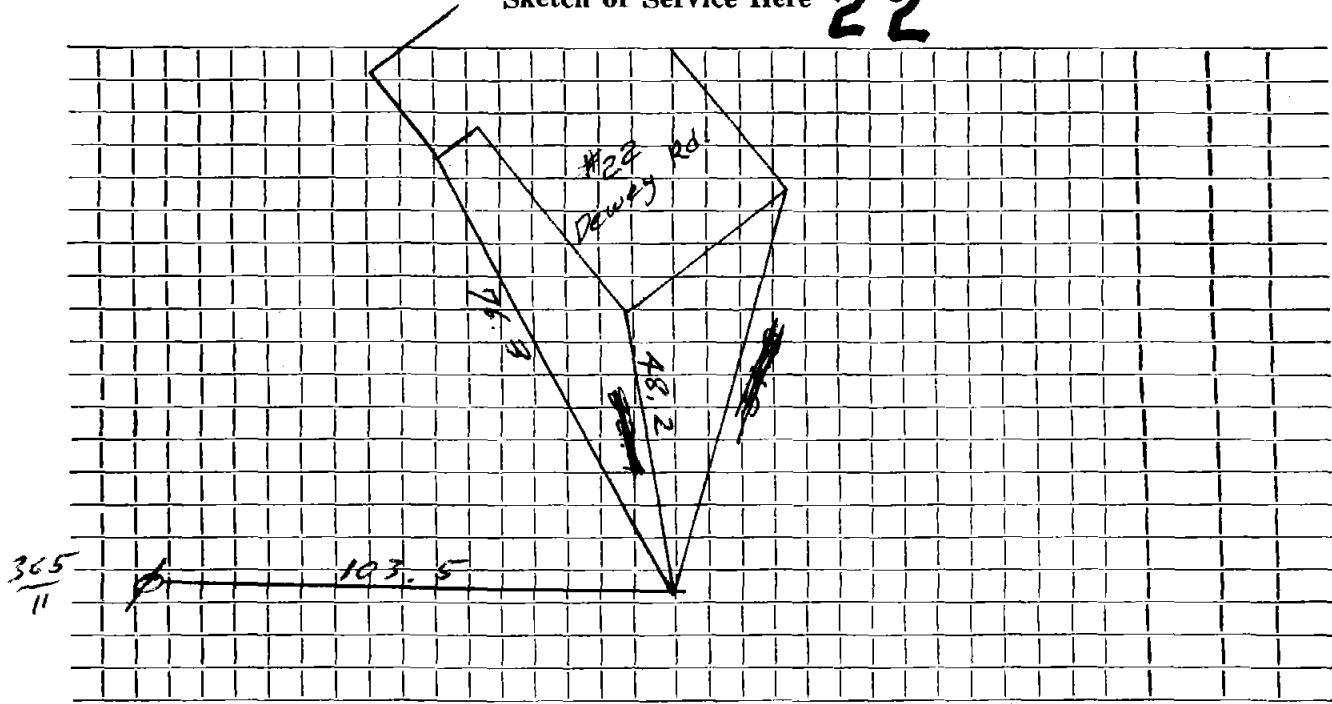

Connection made in Street. Work completed

Remarks:
.....
.....