


DATE _____

TOWN OF LEXINGTON — BOARD OF PUBLIC WORKS
SEWER DIVISION

Sketch of Service Here
23 Dewey Rd. 23

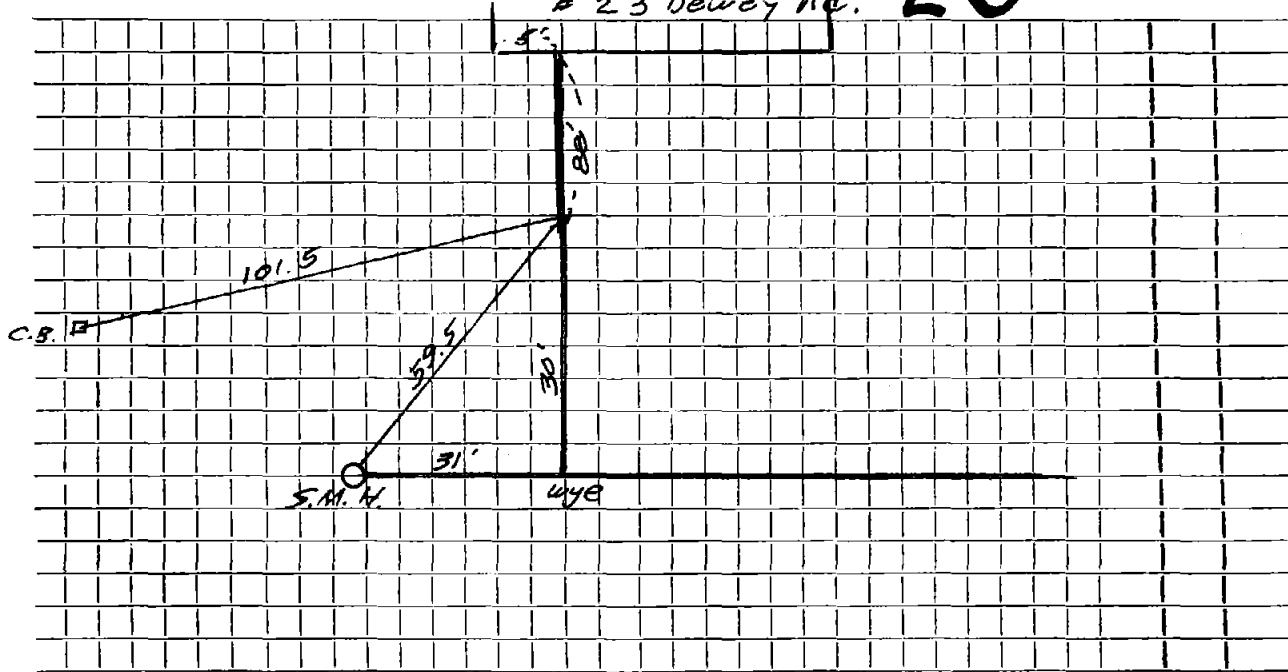

Connection made in Street. Work completed

Remarks:
.....
.....