

Name H. S. Muench

Service No.

Address **24 Dewey Rd.**

24 Dewey Road

Location

Kind of Pipe

Size

Size of Main

Repair—Renewal—New Service

DeFlice #2141

Location


Date	Material	Amount	Total	Date	Amount
8/25/72	110' 6" Transite				
	10' 4" Cast Iron				
				7- -64	
				40' 6" Transite	

DATE _____

TOWN OF LEXINGTON — BOARD OF PUBLIC WORKS

SEWER DIVISION

Sketch of Service Here **24**

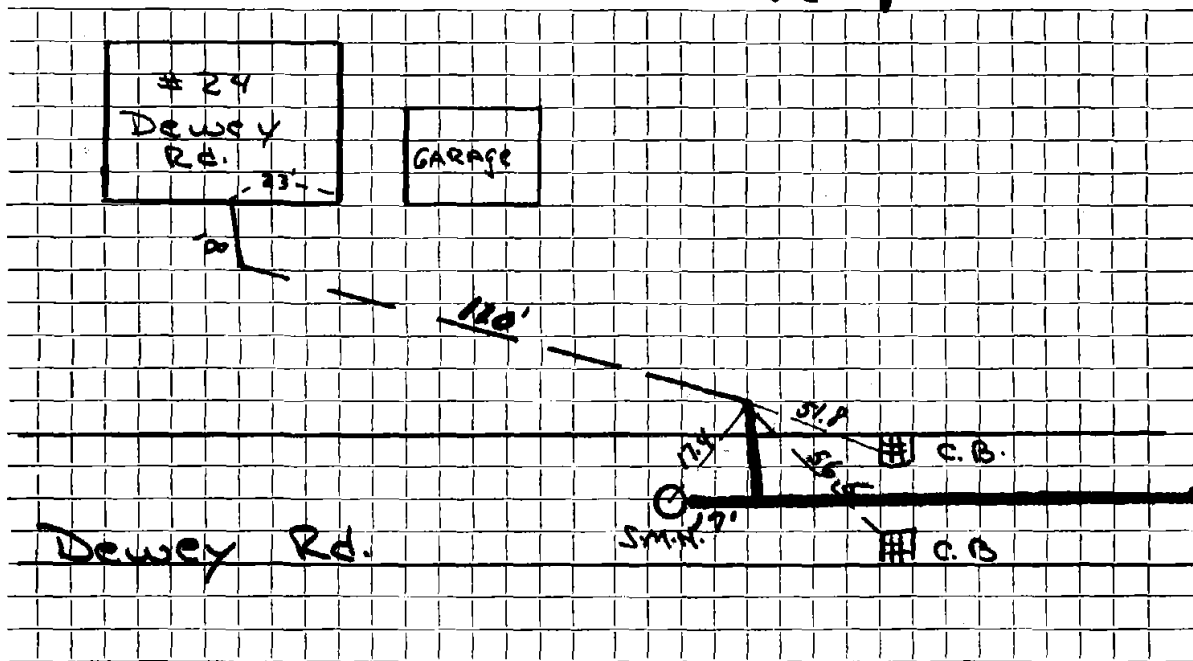

Connection made in Street. Work completed

Remarks:

.....
.....