

DATE _____

TOWN OF LEXINGTON — BOARD OF PUBLIC WORKS


SEWER DIVISION

Lot #6

Sketch of Service Here

26

*26

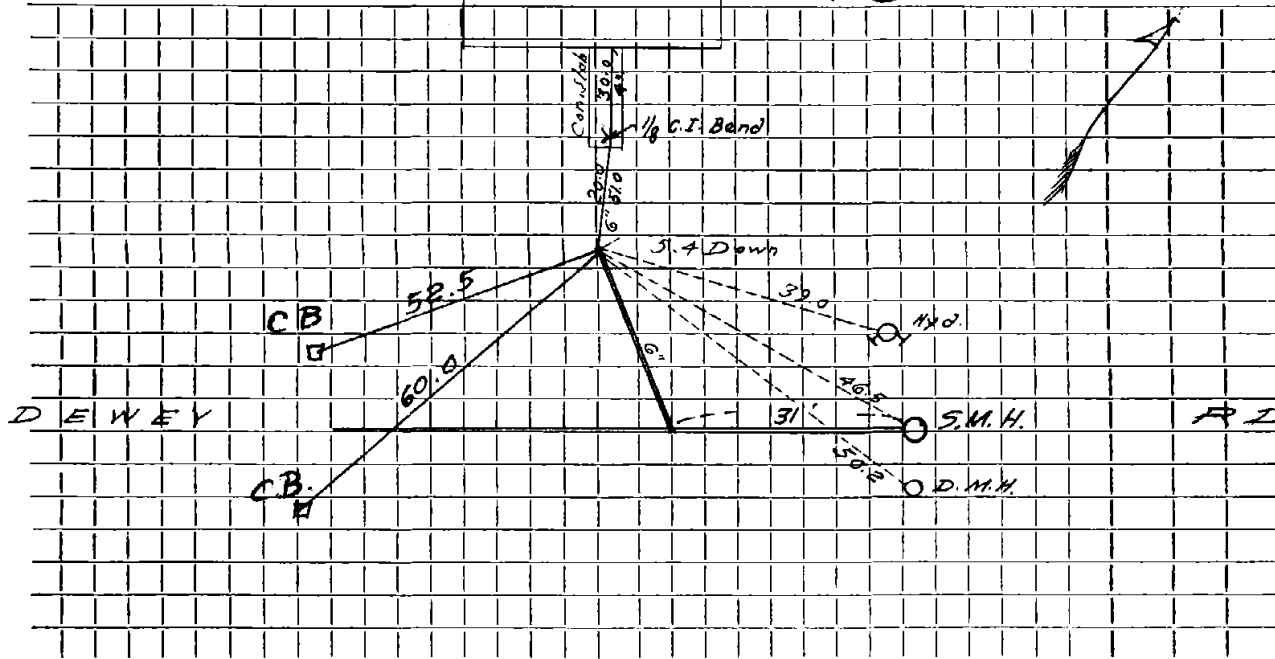

Connection made in Street. Work completed

Remarks:
.....
.....