

Name

Service No.

Address 27 Dewey Rd

Location

Kind of Pipe

Size

Size of Main

Repair—Renewal—New Service

Location

Date	Material	Amount	Total	Date		Amount
July 64	35' 6" A.C. Pipe					
12-6-65	111' 6" A.C. Pipe					
				7- - 64	35' 6" A.C. Pipe	
				7-7-89	Roots 145' out	


DATE _____

TOWN OF LEXINGTON — BOARD OF PUBLIC WORKS

SEWER DIVISION

Sketch of Service Here

27

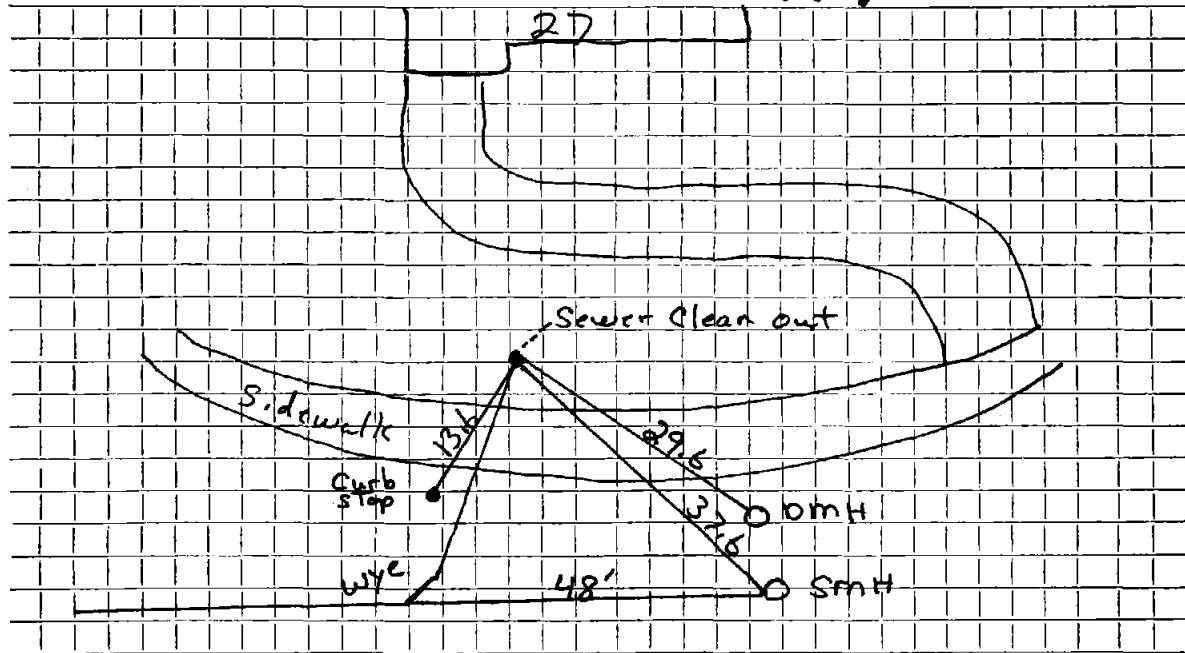

Connection made in Street. Work completed

Remarks: ... 6" PVC Clean out installed about 1' deep upside down curb box
Used to mark for pick-up