

Name Gerald D. Shirley

Service No.

Address 28 Dewey Road

Lot 47

Location

Kind of Pipe

Size

Size of Main

~~Repair Renewal~~ New Service

J.M.Lucente Permit #37

Location


Date		Material	Amount		Total		Date			Amount
July 164	30'	6" Transite pipe								
							7-	64		
							30'	6" Transite		

DATE _____

TOWN OF LEXINGTON — BOARD OF PUBLIC WORKS

SEWER DIVISION

Sketch of Service Here

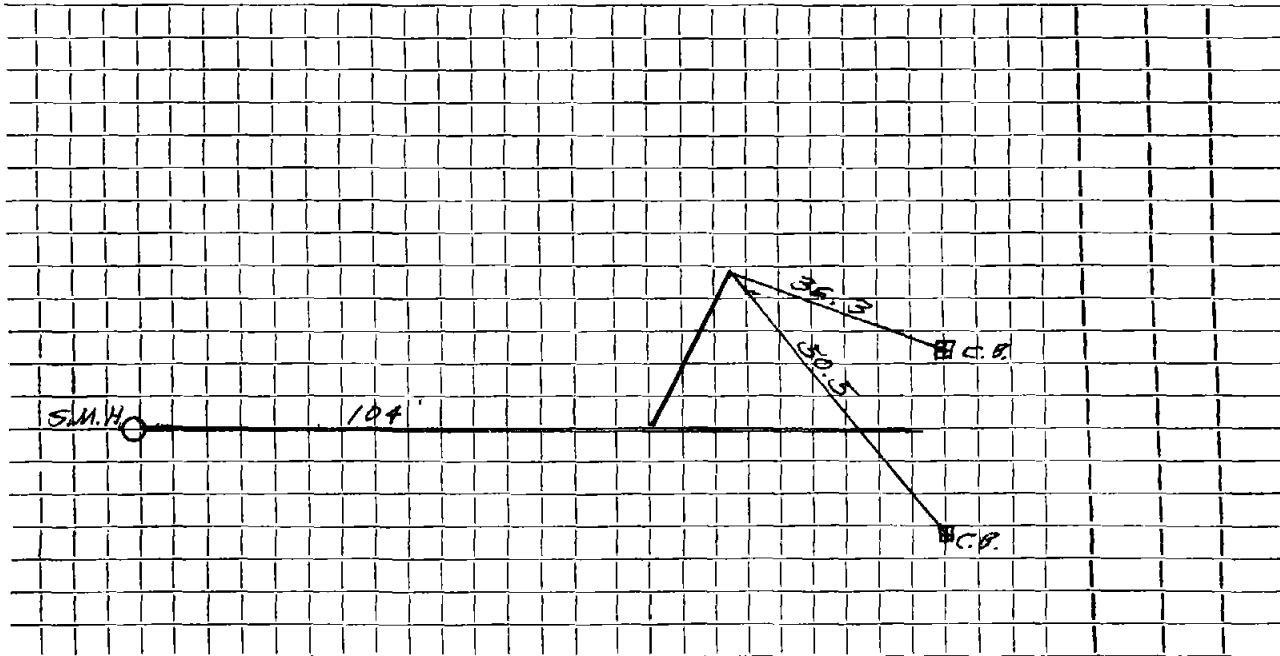

Connection made in Street. Work completed

Remarks:

.....
.....