

Name PAUL WAXMAN

Service No.

Address # 3 Dewey Road

Lot 16

Location

Kind of Pipe

Size

Size of Main

Repair—Renewal—**New Service**


15.00 PERMIT NO. 0959-ROCKWELL location

Date		Material	Amount	Total	Date		Amount
Oct.	'67 21'	6" Transite pipe@6.50		136.50			
5/21/1997		87'-6" Ø PVC WYE C.O. 22° SWEEP					

DATE MAY 21, 1997

TOWN OF LEXINGTON — BOARD OF PUBLIC WORKS
SEWER DIVISION

Sketch of Service Here

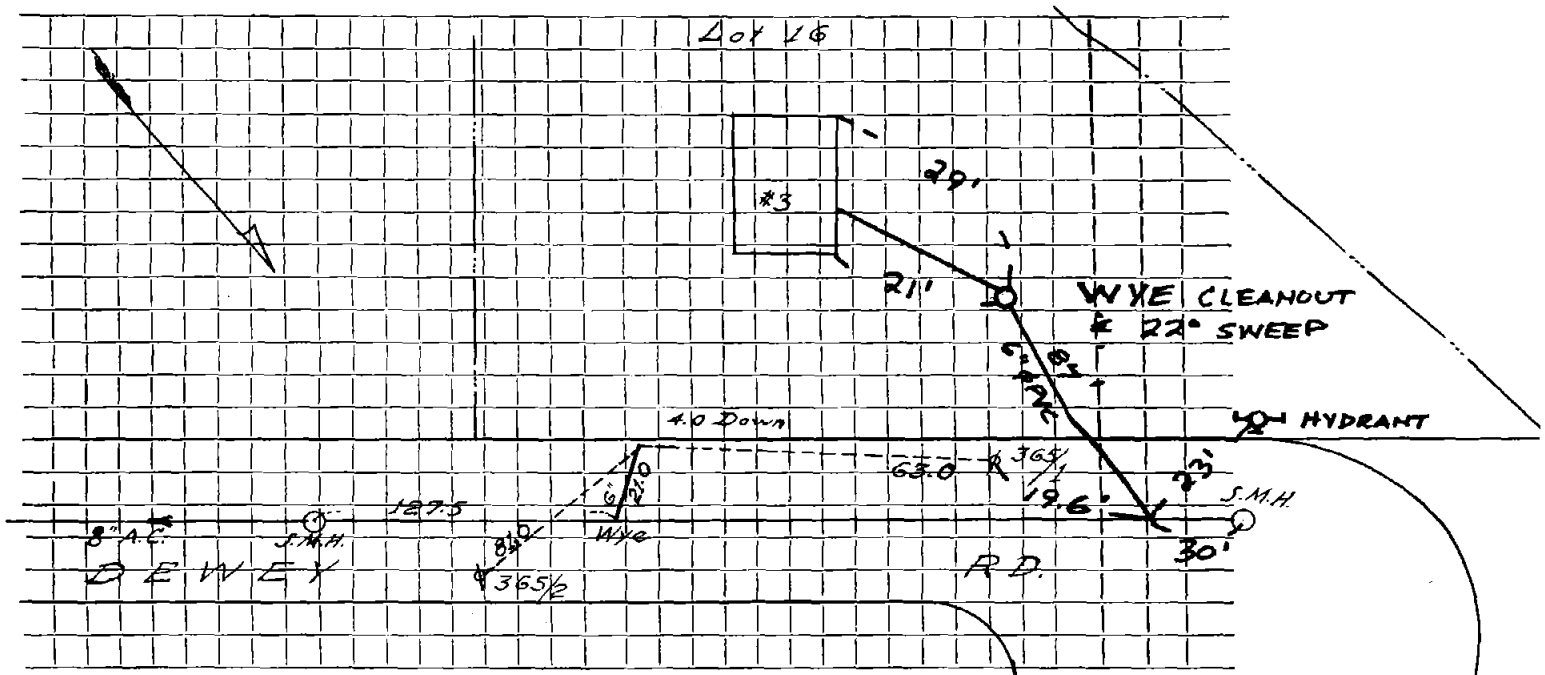

Connection made in DEWEY ROAD Street. Work completed

Remarks:

BOOK 97-2

J.W.