

Name Gerald D. Shirley

Service No.

Address 30 Dewey Road

Lot 48

Location

Kind of Pipe

Size

Size of Main

Renewal ~~Renewal~~ New Service

J.M. Lucente Permit #36

Location


Date	Material	Amount	Total	Date	Amount
July 164	30' 6" Transite pipe				
				7- - 64	
				30' 6" Transite	

DATE _____

TOWN OF LEXINGTON — BOARD OF PUBLIC WORKS

SEWER DIVISION

Sketch of Service Here

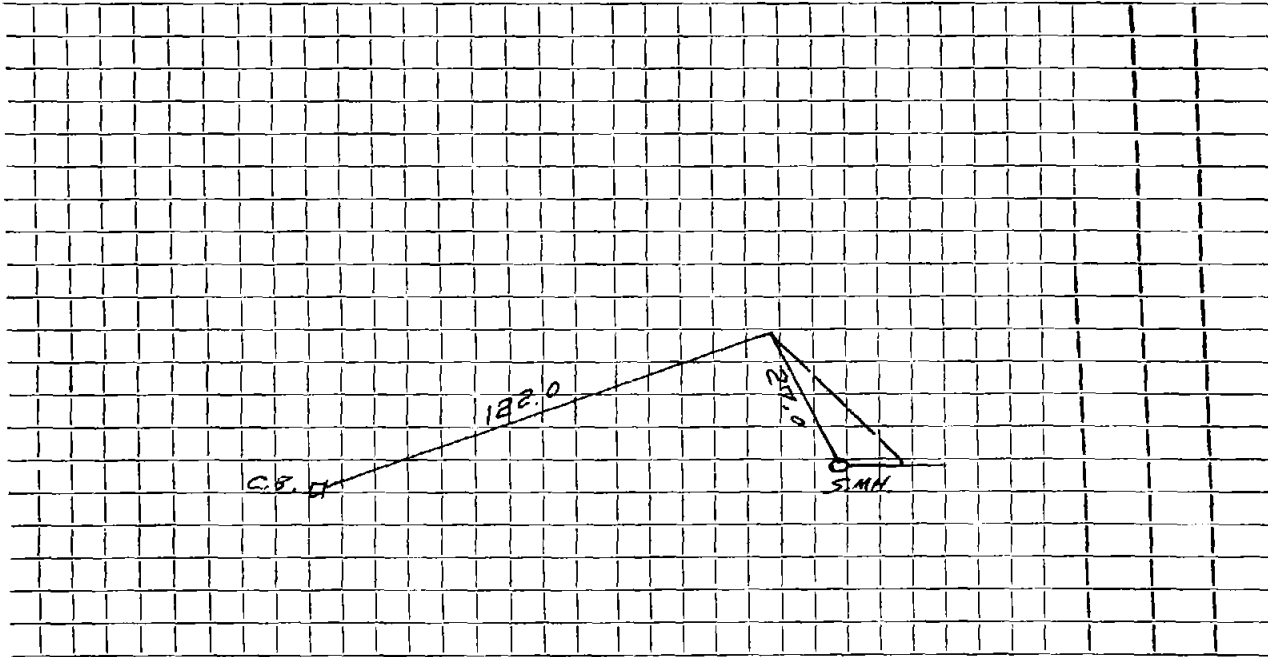

Connection made in Street. Work completed

Remarks:

.....

.....