


DATE _____

TOWN OF LEXINGTON — BOARD OF PUBLIC WORKS

SEWER DIVISION

Sketch of Service Here

4

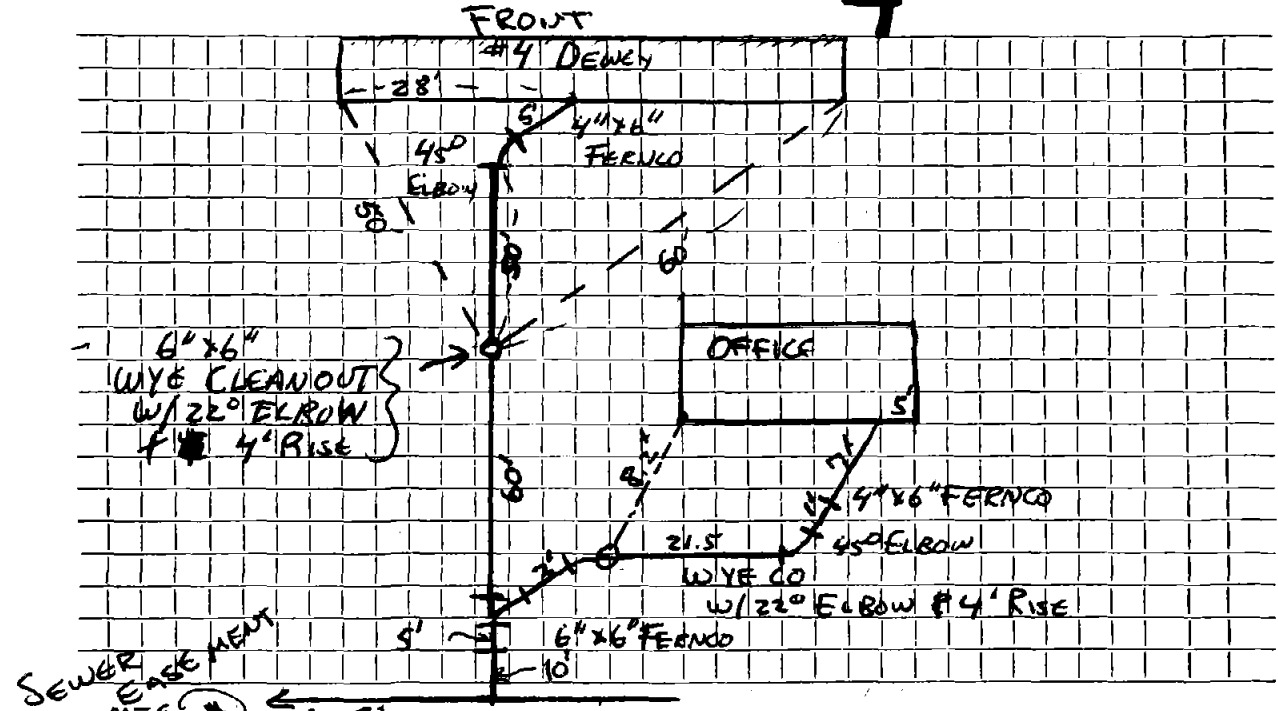

Connection made in _____ Street. Work completed _____

Remarks: ORIGINAL... Service of p. main cannot be used for #4. Its to high off Dewey Rd.