

Name Maurice M. Carey

Service No. 76

Address # 5 Dewey Road

Lot 17

Location

Kind of Pipe

Size

Size of Main

Repair—Renewal—New Service

Lucente #1178

Location

JAN 27 1969


Date	Material	Amount	Total	Date	Amount
Oct. '67	21' 6" Transite pipe	6.50	136.50	8-27-68	136.50
9-17-68	180' 6" Transite pipe				
	5' 4" Transite pipe				
				10- - 67	
				21' 6" Transite	

DATE _____

TOWN OF LEXINGTON — BOARD OF PUBLIC WORKS
SEWER DIVISION

Sketch of Service Here

5

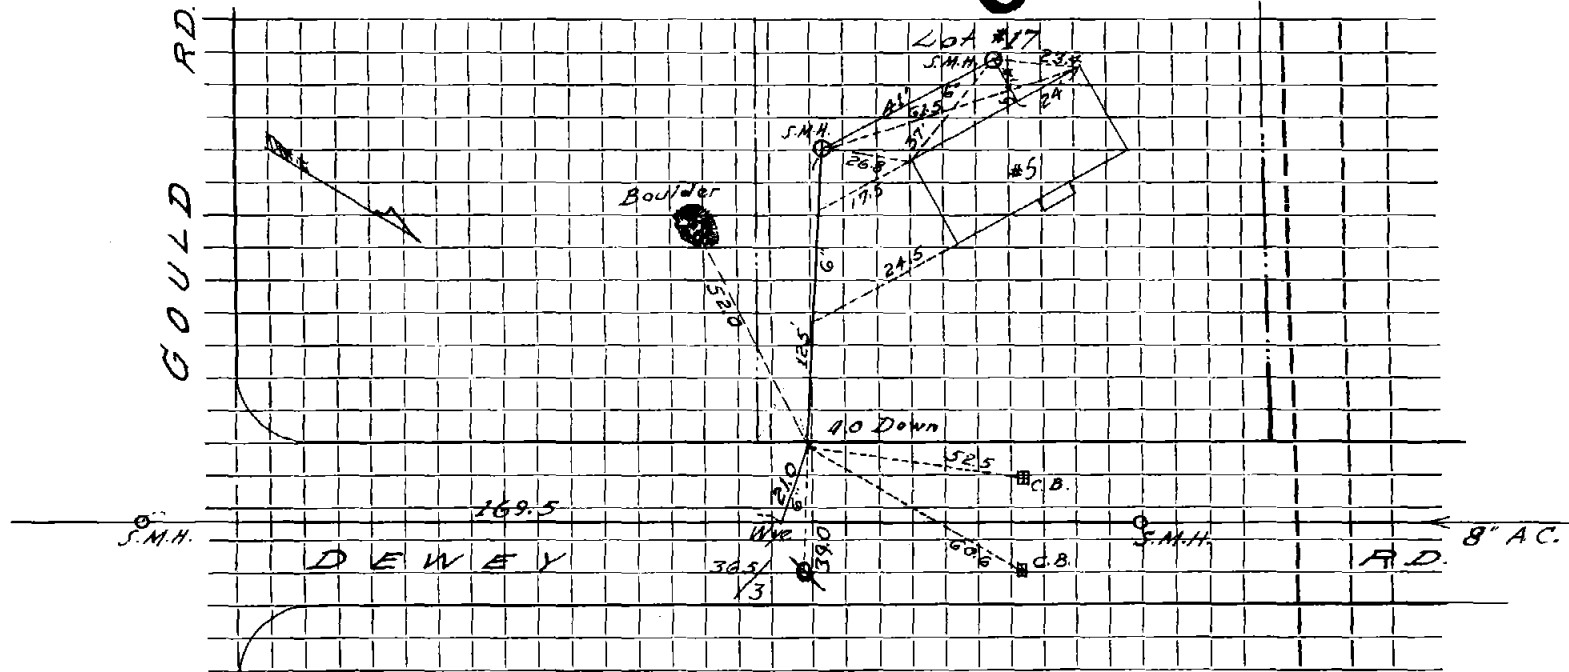

Connection made in Street. Work completed

Remarks:

.....

.....