


DATE 1/5/94

TOWN OF LEXINGTON — BOARD OF PUBLIC WORKS

SEWER DIVISION

Sketch of Service Here

8

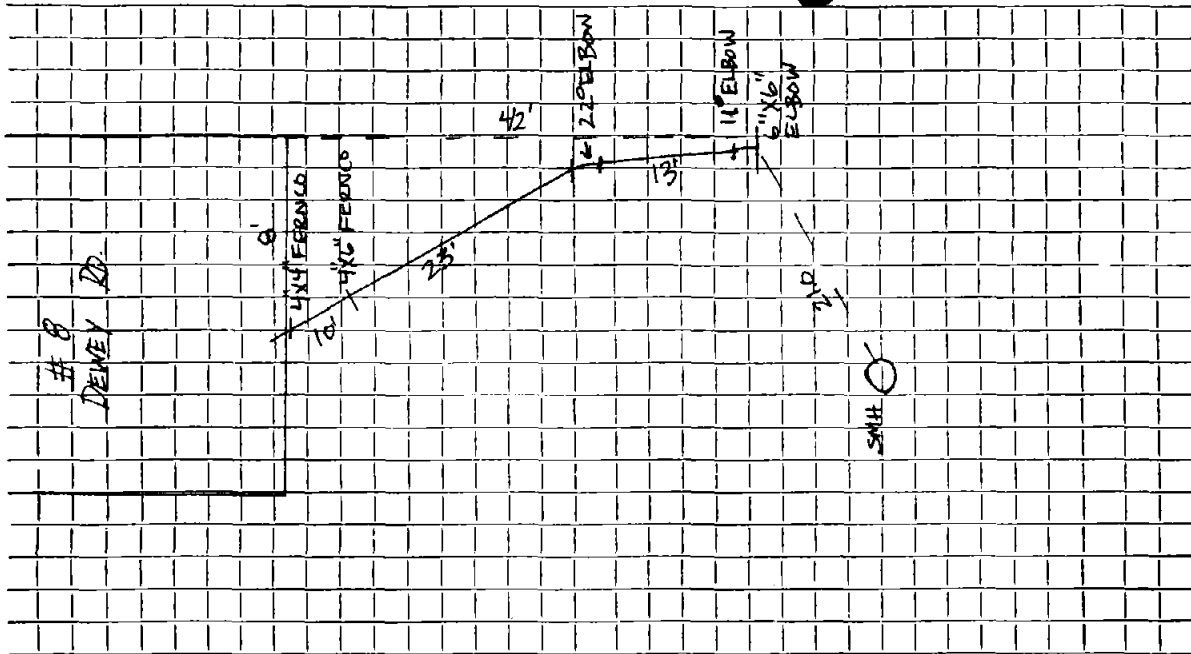

Connection made in Street.

Work completed 6/22/93 GAYLOR, INC......

Remarks:

.....

.....