

Name

Service No.

Address

14 Dexter

Location

Kind of Pipe

6" SDR 35

Size

6"

Size of Main

Repair

~~Renewal~~

New Service

Location

Date

Material

Amount

Total

Date

Amount

5/12/20


6" cleanout  
6" - 22° bend  
6" Saddle  
6" SDR 35

55'

DATE May 12, 2020

TOWN OF LEXINGTON — BOARD OF PUBLIC WORKS  
SEWER DIVISION

Sketch of Service Here

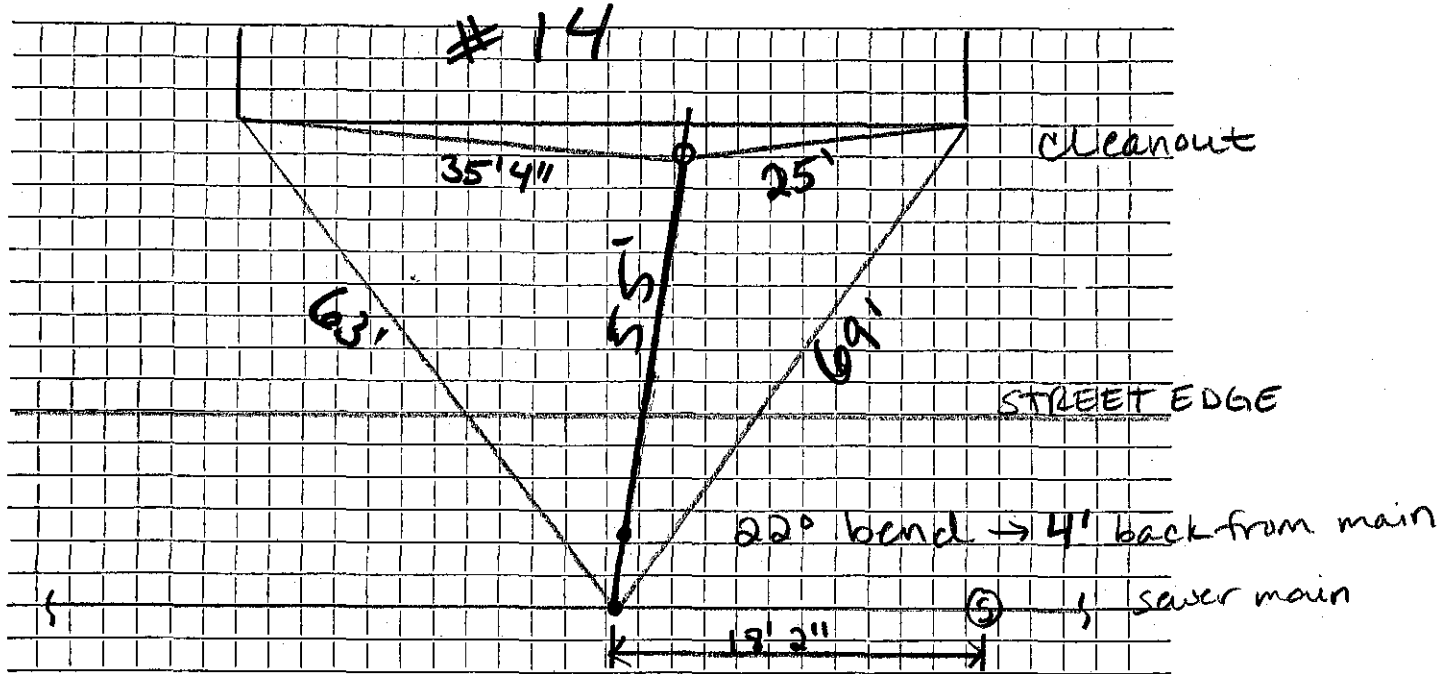

Connection made in Dexter Street. Work completed .....

Remarks: Saddle connection to main