

Name Mrs. Ruth Woodward

Service No. ~~89~~ 1137

Address 15 Dexter Road

Location 15 Dexter Road

Kind of Pipe

Size

Size of Main

~~Repair/Renewal~~ New Service

Location

Date	Material	Amount	Total	Date	Amount
Dec. 9, '47	Labor	32 50	32 50	Dec. 5 '47	125 00
	10% Overhead		3 25	Dec. 31 '47	37 39
	48' 6" Sewer Pipe @ .26		12 48		87 61
	Joint Compound		2 88		
	Hired Shovel 2 hrs. @ 7.00		14 00		
	Loader 2 hrs. @ \$3.00		6 00		
	Trucking 2 hrs. @ .75		1 50		
	Patching 15 x 3		15 00		
			87 61		
	Labor				
	<i>Com 12/15/47</i>				

TOWN OF LEXINGTON—DEPT. OF PUBLIC WORKS

SEWER DIVISION

DATE

NO.


The undersigned applies for the construction of a particular sewer connecting No. Street and hereby agrees to comply with the Rules and Regulations governing the construction and use of Particular Sewers, as now or at any future time established by the Board of Selectmen.

Am't of estimate \$.....

Am't Paid \$.....

..... Owner

Sketch of Service Here **15**

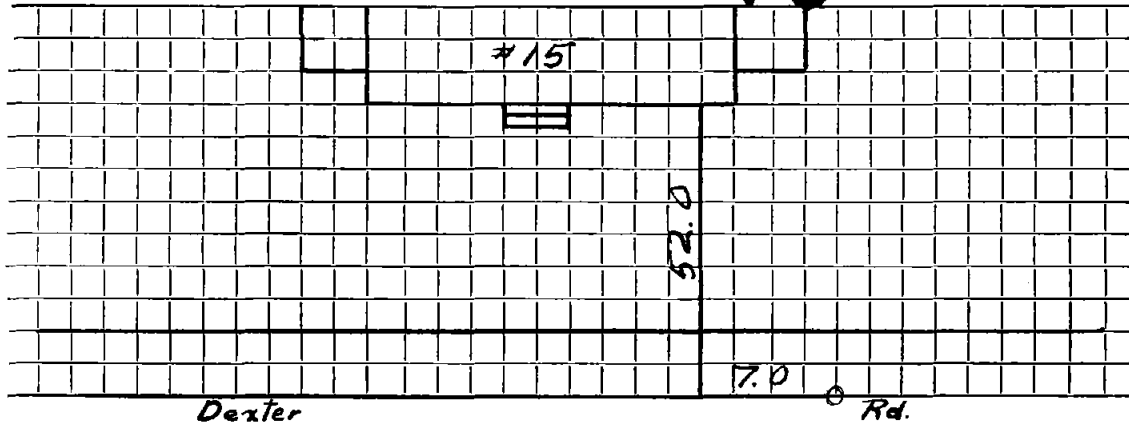

Connection made in Street.

Work completed 19..

Remarks: