

Name **Clarence A. Small**

Service No. **53**

Address **19 Dexter Road**

Location

Kind of Pipe

Size

Size of Main

~~Repair General~~ **New Service** W.O. #8657

Location *Comm 9-21-64*


Date	Material	Amount	Total	Date	Amount
6-15-64	Labor	102 19		7-14-64	165 00
	10% Overhead	<u>10 22</u>	112 41	7-15-64	5 87
	52' 6" Transite pipe @ .82		42 64	11-6-64	<u>23 32</u>
	1 Bag Cement		1 50		182 45
	1 11 1/4" Transite Bend		4 09		
	1 22 1/2" Transite Bend		4 09		
	9X3 Street Patch		9 00		
	5X5 Driveway Patch		90 00		
	1 Yard Loam		3 00		
	4 Hrs Town Shovel @ 6.50		26 00		
	2 Hrs Town Trucking @ 3.00		<u>6 00</u>		
			298 73		
			<i>0</i>		
	PRO-Rated <u>298.73</u> X 16.25 =	191.19			
	25				

DATE _____

TOWN OF LEXINGTON — BOARD OF PUBLIC WORKS

SEWER DIVISION

Sketch of Service Here **19**

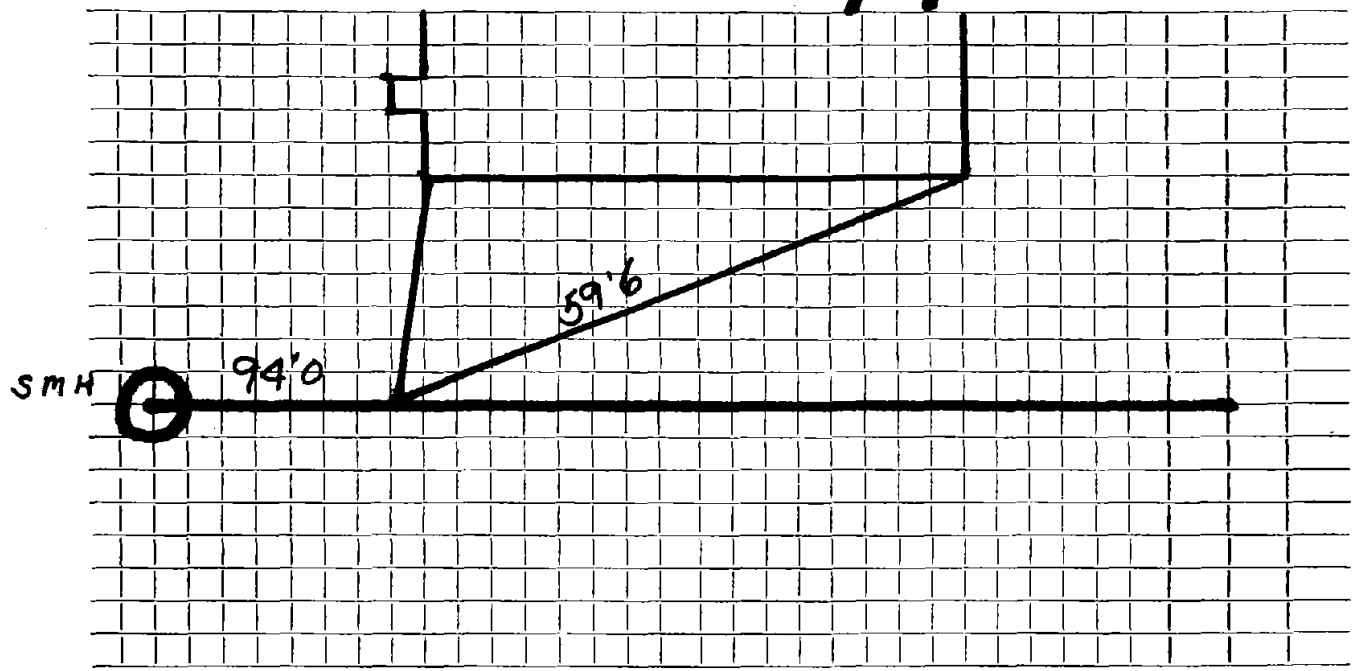

Connection made in Street. Work completed

Remarks: *Original Service 3-22-48*

.....
.....