

Name Myles F. Heffernan

Service No. 22

Address 22 Dexter Road

Lexington

Location

Kind of Pipe

COM. 6-16-52

Size

Size of Main

~~Repair~~ ~~Renewal~~ New Service

Location

Date	Material	Amount	Total	Date	Amount
1/24/52	Labor	27 97		3-28-52	150 00
	10% overhead	2 80	30 77	6-16-52	38 95
	52' - 6" sewer pipe @ .342		17 78		111 05
	1- 6" elbow		1 88		
	joint. compound		3 12		
	6 hrs. Littlefield shovel		42 00		
	2 hrs. trucking		1 50		
	patching 14 x 3		14 00		
			111 05		
	Labor				

TOWN OF LEXINGTON—DEPT. OF PUBLIC WORKS

SEWER DIVISION

DATE

NO.


The undersigned applies for the construction of a particular sewer connecting No.
 Street and hereby agrees to comply with the Rules and Regulations governing the construction and use of Particular
 Sewers, as now or at any future time established by the Board of Selectmen.

Am't of estimate \$.

Am't Paid \$.

..... Owner

Sketch of Service Here **22**

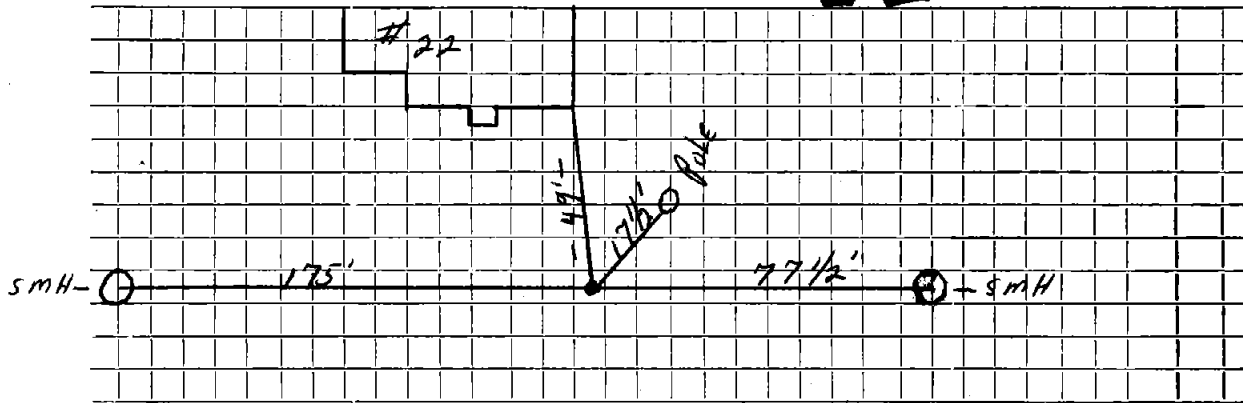

Connection made in 11/30/70 Street.
 Remarks: CONNECTION FOR #23 & 22 ARE ON SAME TEE
 TRANS TEE - 2-1'X6" NIPPLES & ADAPTED

Work completed 19..