

Name William F. Reed

Service No. 185

Address 23 Dexter Rd.

Lexington

Location

Kind of Pipe

Size

Size of Main

~~Repair~~ ~~Renewal~~ ~~New Service~~

Cam. 12-31-52

Location

Date	Material	Amount	Total	Date	Amount
12/22/52	Labor	38 67		11-28-52	Deposited 150 00
	10% overhead	3 89	42 56	12-31-52	Refunded (22 57)
	46'-6" Sewer pipe @.342		15 73		127 43
	1-6" Elbow		1 88	12-2-70	Renewal
	Joint Compound		2 76		20' 6" Transite
	7 Hr. Littlefield Shovel		49 00		1 6" Tee
	2 Hr. Trucking		1 50		1 6" Elbow
	Patching 14 x 3		14 00		1 6"-11/4" Sweep
12-2-70	Renewal		127 43		
	28' 6" Transite				
	1 DONUT				
	Labor				

TOWN OF LEXINGTON—DEPT. OF PUBLIC WORKS
SEWER DIVISION

DATE

NO.


The undersigned applies for the construction of a particular sewer connecting No.
Street and hereby agrees to comply with the Rules and Regulations governing the construction and use of Particular
Sewers, as now or at any future time established by the Board of Selectmen.

Am't of estimate \$.....

Am't Paid \$.....

..... Owner

Sketch of Service Here **23**

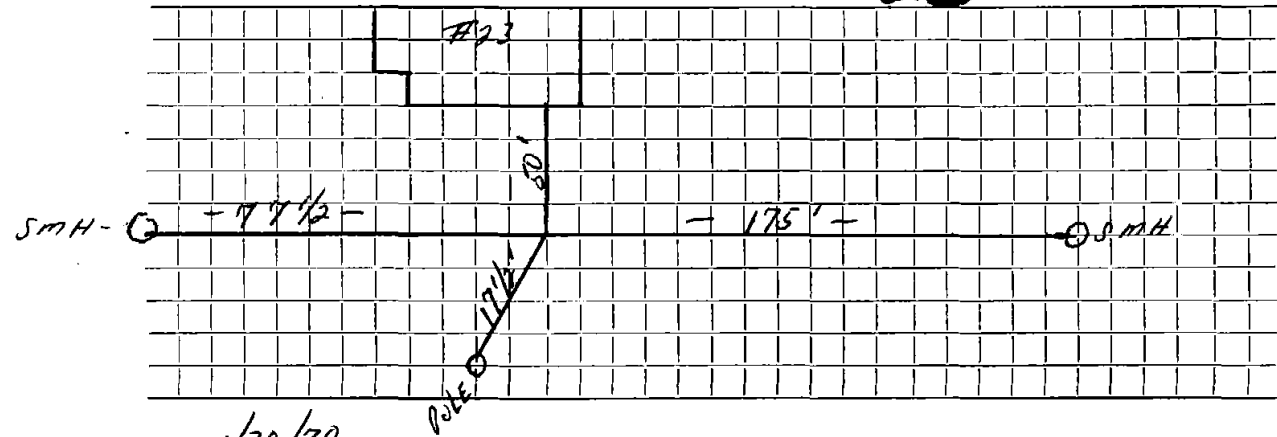

Connection made in 11/30/70 Street.

Work completed 19..

Remarks: TEE FOR BOTH #22-23