

Name

Service No.

Address

26 Dexter Bldg

Location

Kind of Pipe

Size

Size of Main

Repair—Renewal—New Service

Location

Date

Material

Amount

Total

Date

Amount

11.14.00


Outside put in
6x8 saddle
2- 45° Bends
3'.6" - nipple off Bend
13'.6" - 6" PVC

DATE _____

TOWN OF LEXINGTON — BOARD OF PUBLIC WORKS

SEWER DIVISION

Sketch of Service Here

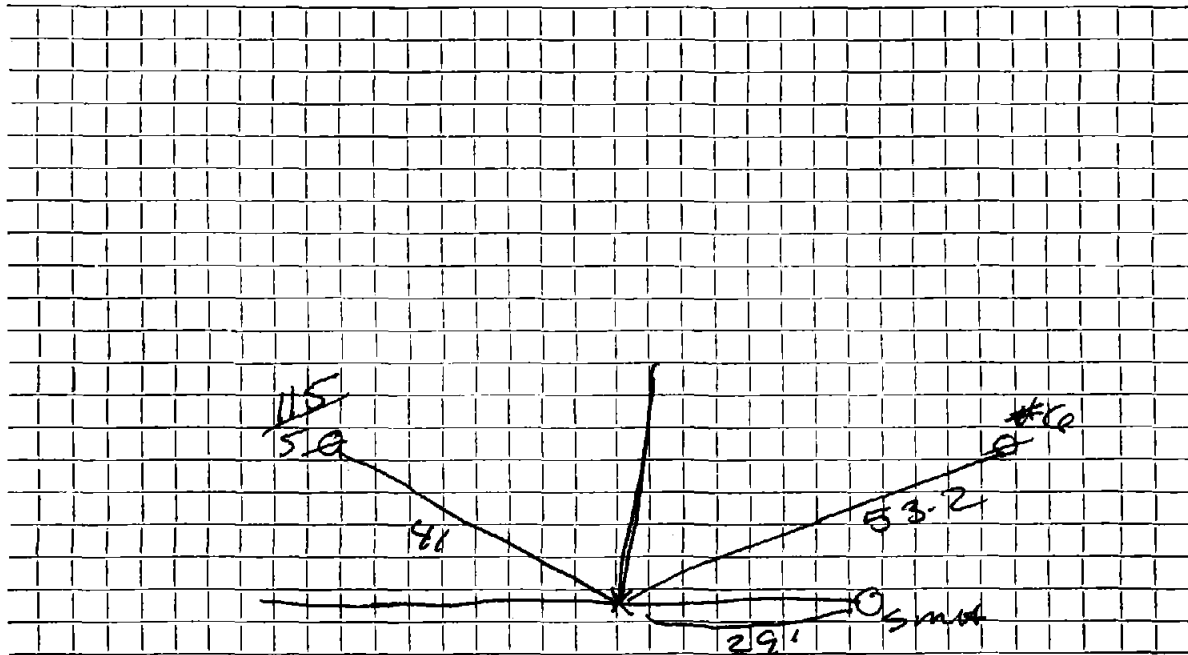

Connection made in Street. Work completed

Remarks: .. Contactor tapped sewer main 7" 6" Deep
6x8 saddle with 45° Bend 3 1/2 foot nipple to 45° Bend