

Name Edwin B. Worthen

Service No. 123

Address 35 Dexter Road

Location

Kind of Pipe

Size

Size of Main

~~Repair~~ ~~Renewal~~ ~~New Service~~ W.O. # 7691

Location JAN 27 1969


Date	Material	Amount	Total	Date	Amount
11/25/68	Labor	65 80		11-25-68	300 00
11/27/68	"	30 10	95 90	1-27-69	172 31
	10% O.H.		9 60		127 69
	30' Transitepipe .88		26 40	11/25/68	Labor 66 98
	1 22 1/2" Elbow		2 35	11/27/68	" 84 70
	1 11 1/2" Elbow		2 35	60' 6" Transitepipe .88	52 80
	1 Adapter		1 62	2 11 1/2" Ells @ 2.35	4 70
	1/2 Bag cement 1.55		78	1/2 Bag cement @ 1.55	78
	3 Ton Loam @ 3.50		10 50	5 Ton hot top @ 5.80	29 00
	2 Hrs. Trucking @ 3.00		6 00	3 1/2 Hrs trucking @ 3.00	10 50
	3 1/2 " Shovel @ 6.50		22 75	4 " shovel @ 6.50	26 00
			178 25	2 " compressor @ 5.00	10 00
	PRO-RATED 178.25 x 17yrs.3mo. =		127 69	1 " roller	3 00
				trailer	2 00
				12-1 86 16" - 6" PVC PIPE	290 46
				2 6" x 6" PC-PVC FERRUCO	

DATE _____

TOWN OF LEXINGTON — BOARD OF PUBLIC WORKS

SEWER DIVISION

Sketch of Service Here **35**

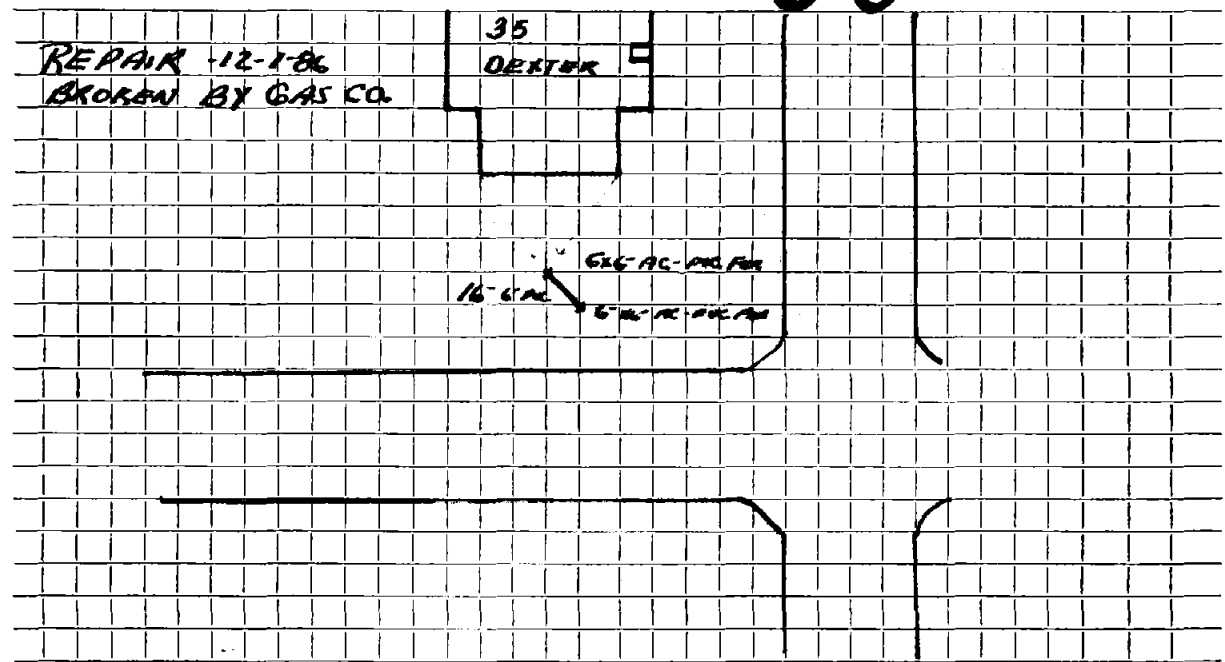

Connection made in Street. Work completed

Remarks:
.....
.....