

Name Donald K. Irwin

Service No. 120

Address 49 Dexter Road

Lexington

Location

Comm. 12-3-56

Kind of Pipe

Size

Size of Main

~~Repair/Reconnect~~ New Service

Location

Date	Material	Amount	Total	Date	Amount
9/5/56	Labor	41 87		8-24-56	Deposit \$ 200 00
	10% Overhead	4 19	46 06	12-3-56	Refund 66 51
	54' - 6" sewer pipe@.435		23 49		133 49
	Joint compound		3 24		
	1 6" elbow		1 88		
	6 2/3 hrs. town shovel@6.50		43 32		
	14 x 3 patch		14 00		
	2 hrs. trucking@.75		1 50		
			133 49		
	Labor				

**TOWN OF LEXINGTON—DEPT. OF PUBLIC WORKS  
SEWER DIVISION**

DATE .....

NO. ....


The undersigned applies for the construction of a particular sewer connecting No. ....  
Street and hereby agrees to comply with the Rules and Regulations governing the construction and use of Particular  
Sewers, as now or at any future time established by the Board of Selectmen.

Am't of estimate \$ .....

Am't Paid \$ .....

..... Owner

**Sketch of Service Here**

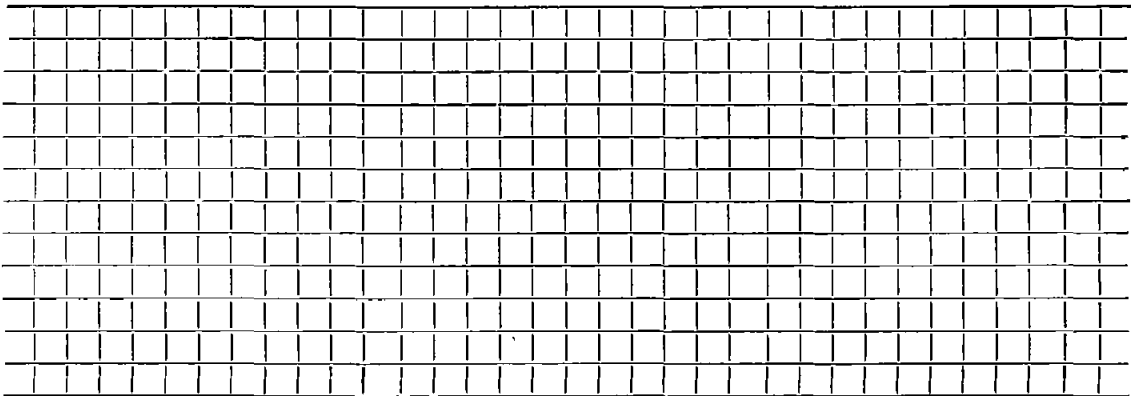

Connection made in ..... Street.

Work completed ..... 19..

Remarks: