

Name Jonn McCormick

Service No. 85 1133

Address 58 Dexter Road

Location 58 Dexter Road

Kind of Pipe

Size

Size of Main

~~Report Blank~~ New Service

Location

Date	Material	Amount	Total	Date	Amount
12/1/47	Labor	47 54	47 54	Nov. 20 47	150 00
	10% Overhead		4 75	Dec. 31 47	31 78
	72' 6" Sewer Pipe		18 72		<u>118 22</u>
	1 6" Elbow		1 18		
	1 6" Y		1 71		
	Joint Compound		4 32		
	2 1/2 Hrs. Hired Shovel @ 7.00		17 50		
	1 hr. Loader		3 00		
	2 hrs. Trucking		1 50		
	Patching 18x3		18 00		
			<u>118 22</u>		
	<b>Labor</b>				
	<i>Oct. 12/1/47</i>				

TOWN OF LEXINGTON—DEPT. OF PUBLIC WORKS  
**SEWER DIVISION**

DATE .....


NO. ....

The undersigned applies for the construction of a particular sewer connecting No. ....  
 Street and hereby agrees to comply with the Rules and Regulations governing the construction and use of Particular  
 Sewers, as now or at any future time established by the Board of Selectmen.

Am't of estimate \$. ....

Am't Paid \$. ....

..... Owner

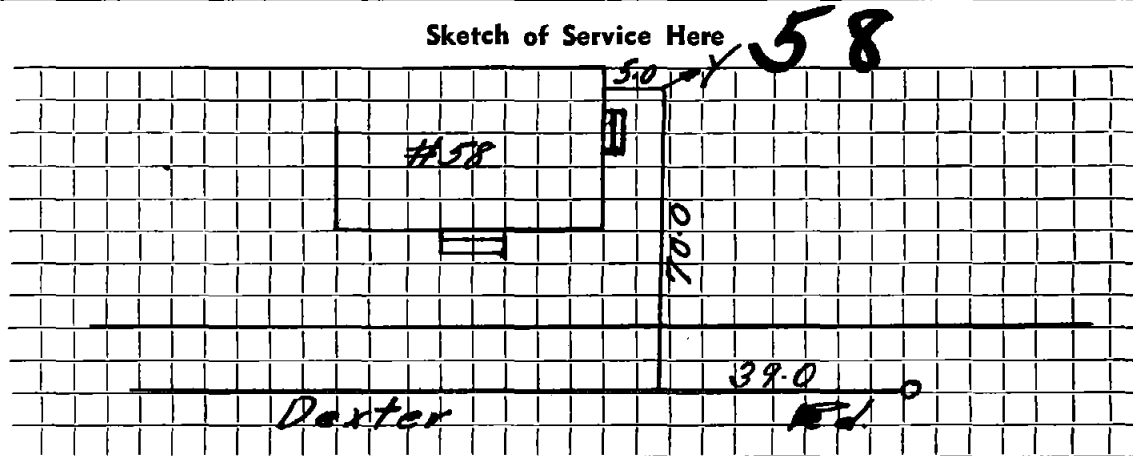

Connection made in ..... Street.

Work completed ..... 19..

Remarks:



TOWN OF LEXINGTON—DEPT. OF PUBLIC WORKS  
**SEWER DIVISION**

DATE .....

NO. ....

The undersigned applies for the construction of a particular sewer connecting No. ....  
Street and hereby agrees to comply with the Rules and Regulations governing the construction and use of Particular  
Sewers, as now or at any future time established by the Board of Selectmen.


Am't of estimate \$.....

Am't Paid \$.....

..... Owner

Sketch of Service Here

58

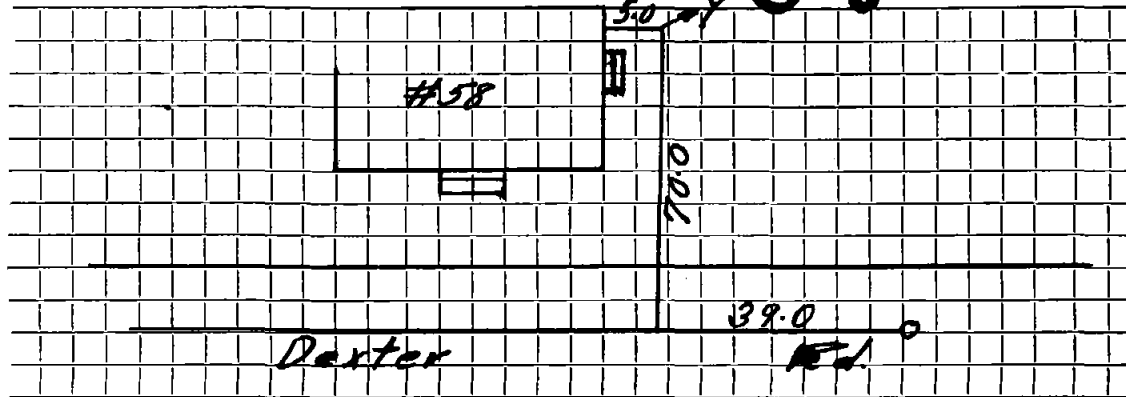

Connection made in ..... Street.

Work completed ..... 19..

Remarks:

T  
O  
C  
W  
I  
D  
F  
I  
A  
O  
A  
I  
R  
T  
S

Name

Service No.

Address

Location

Kind of Pipe

Size

Size of Main

Repair—Renewal—New Service

Location

Date

Material

Amount

Total

Date

Amount

Labor