

Name Donald Irwin  
 Address 63 Dexter Road

Service No. 215

*Cont. 12-31-55* Location

Kind of Pipe Size Size of Main  
~~Repair~~ ~~Renewal~~ — New Service Location

Date	Material	Amount	Total	Date	Amount
12/2/55	Labor	13 30		10-27-55	150 11
12/3/55	"	20 69	33 99	12-31-55	12 63
	10% overhead		3 40		137 37
	60' - 6" sewer pipe @ .50		30 00		
	joint compound		3 60		
	1-6" elbow		1 88		
	12 x 3 patching		12 00		
	5-2/3 hrs. Littlefield shovel @ .00		51 00		
	2 hrs. trucking @ 75¢		1 50		
			<u>137 37</u>		
	<b>Labor</b>				

**TOWN OF LEXINGTON—DEPT. OF PUBLIC WORKS**  
**SEWER DIVISION**

DATE.....

NO. ....


The undersigned applies for the construction of a particular sewer connecting No.....  
 Street and hereby agrees to comply with the Rules and Regulations governing the construction and use of Particular  
 Sewers, as now or at any future time established by the Board of Selectmen.

Am't of estimate \$.....

Am't Paid \$.....

..... Owner

**Sketch of Service Here**

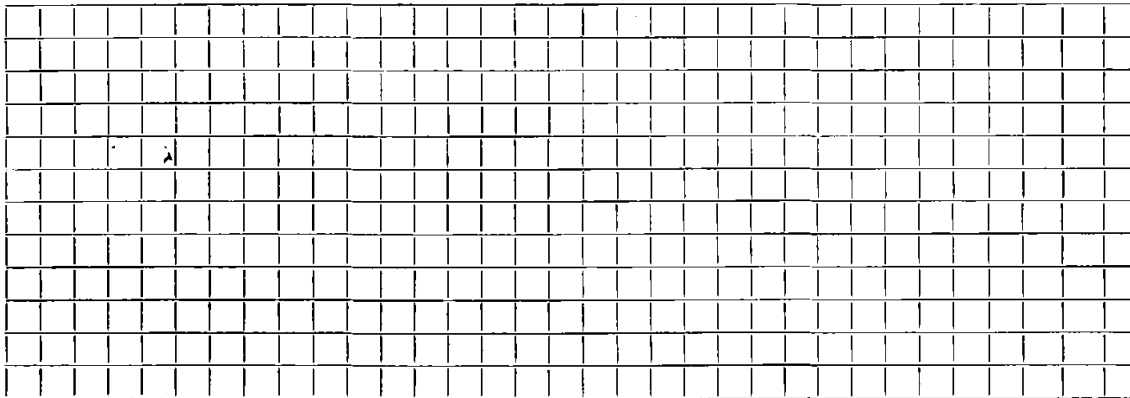

Connection made in..... Street.

Work completed.....19..

Remarks: