

Name Benjamin Franklin Homes

Service No. 69

Address 10 Diamond Road

Lot 9 Stg 7189

Location

Kind of Pipe

Size

Size of Main

~~Repair~~ ~~Renewal~~ ~~x~~ New Service

Location Comm 10-28-63

Date	Material	Amount	Total	Date	Amount
9-24-62	Labor	40.97		6-14-63	200.00
	10% O.H.	4.10	45.07	11-8-63	81.06
	24' 6" Transite pipe @.32		19.68		281.06
	1 6" Transite End Cap		1.93		
	2 hrs. Trucking @3.00		6.00		
	4 hrs. Pumping @1.00		4.00		
	BILL WHEN CONNECTED		76.68		
7-3-63	Labor	106.14			
	10% O.H.	10.61	116.75		
	74' 6" Transite pipe @.82		60.68		
	1 11 $\frac{1}{4}$ " Transite Elbow		2.24		
	1 11 $\frac{1}{4}$ " Transite Bend		4.09		
	1 6" Duplex Adapter		1.62		
	2 Hrs. Town Shovel @6.50		13.00		
	2 Hrs. Trucking @3.00		6.00		
			281.06		


DATE \_\_\_\_\_

TOWN OF LEXINGTON — BOARD OF PUBLIC WORKS  
SEWER DIVISION

Sketch of Service Here

10

LOT 9

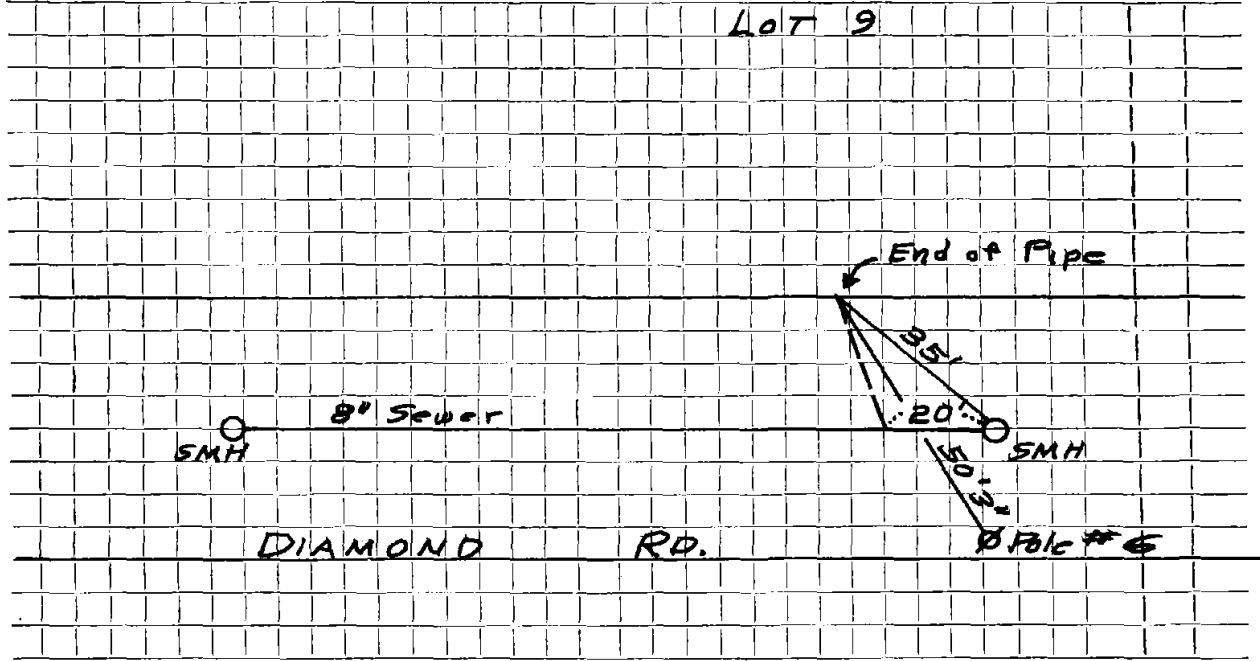

Connection made in ..... Street. Work completed .....

Remarks: .....  
.....  
.....