

Name Benjamin Franklin Homes, Inc.

Service No. #129

Address 11 Diamond Road

Lot 5 Sta. 9+17

Location

Kind of Pipe

Size

Size of Main

~~Repair~~ ~~Renewal~~ ~~X~~ - New Service W.O. #7534

Location *Comm 10-29-62*

Date	Material	Amount	Total	Date	Amount
9-7-62	Labor	48.54		8-13-62	125.00
	10% O.H.	4.85	53.39	11-5-62	22.40
106'	6" Transite pipe @82		86.92		147.40
1	11 1/4" Transite Bend		4.09		
1	Hr. Trucking @3.00		3.00		
			147.40		


DATE \_\_\_\_\_

TOWN OF LEXINGTON — BOARD OF PUBLIC WORKS

SEWER DIVISION

Sketch of Service Here

11

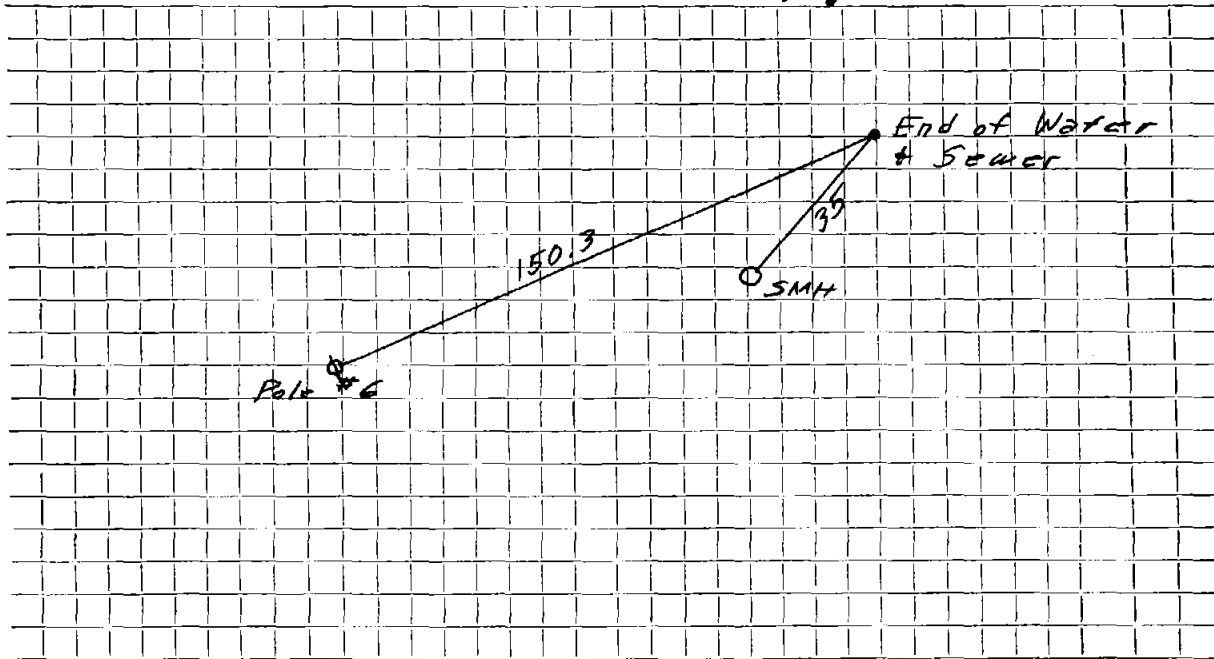

Connection made in ..... Street. Work completed .....

Remarks: .....

.....

.....