

Name Ben Franklin Homes

Service No. 11

Address 12 Diamond Road

Lot #8 Sta. 9+41

Location

Kind of Pipe

Size

Size of Main

~~Repair~~ ~~Reconnect~~ New Service

WC # 2813

Location Conn 8-26-63


Date	Material	Amount	Total	Date	Amount
2-25-62	Labor	52.33		4-3-63	Deposit 150.00
	10% O.H.	5.23	57.56	8-26-63	Refund 30.3
	30' 6" Transite pipe @.82		24.60		146.97
	2 hrs. Trucking @3.00		6.00		
	4 hrs. Pumping @1.00		4.00		
	BILL WHEN CONNECTED		92.16		
	62' 6" Transite pipe @.82		50.84		
	1 22 1/2" Transite Elbow		2.35		
	1 Duplex Adapter		1.62		
			146.97		

DATE _____

TOWN OF LEXINGTON — BOARD OF PUBLIC WORKS
SEWER DIVISION

Sketch of Service Here

12

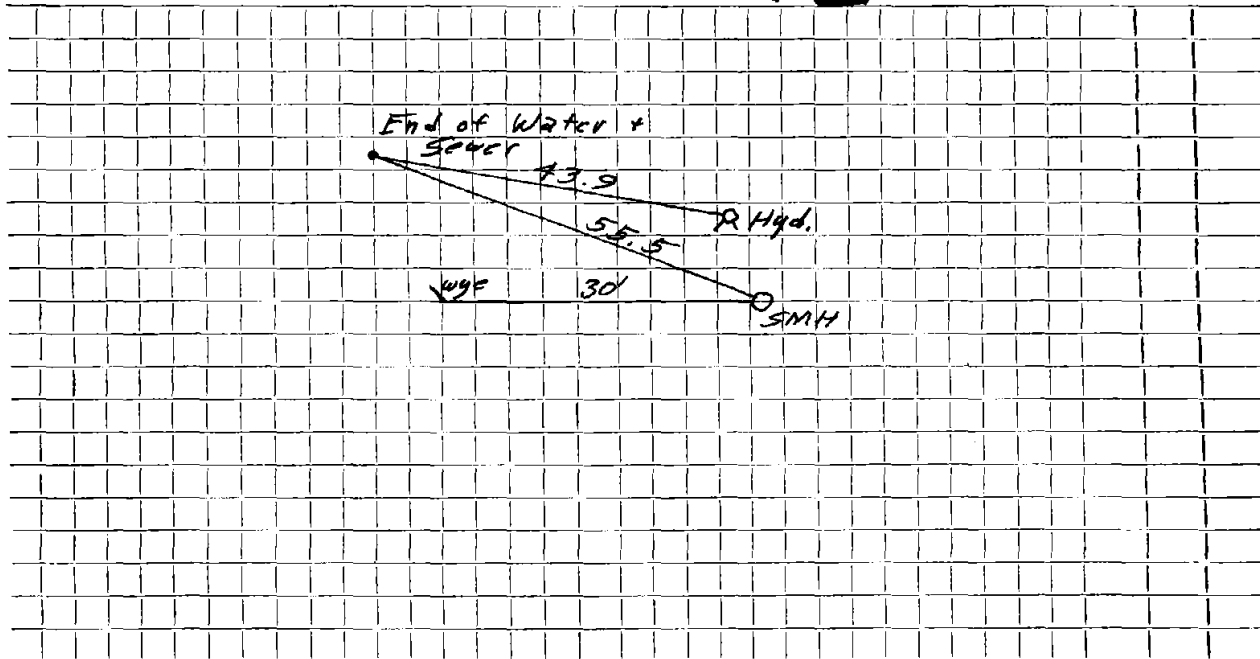

Connection made in Street. Work completed

Remarks:

.....
.....