

Name Benjamin Franklin Homes, Inc.

Service No. 130

Address 15 Diamond Road

Lot 6 Sta. 10+69

Location

Kind of Pipe

Size

Size of Main

~~Repair~~ ~~Renewal~~ — New Service

W.O. #7535

Location *Comm 10-29-62*

Date	Material	Amount	Total	Date	Amount
9-6-62	Labor	58.74			
	10% O.H.	5.87	64.61	8-13-62	Deposit 125.00
	99' 6" Transite Pipe @82		81.18	11-5-62	38.29
	1 6" Duplex Adapter		1.62		163.29
	2 11 1/4" Transite Bend @4.09		8.18		
	2 11" Transite Elbow @2.35		4.70		
	1 Hr. Trucking @3.00		3.00		
			163.29		


DATE \_\_\_\_\_

TOWN OF LEXINGTON — BOARD OF PUBLIC WORKS

SEWER DIVISION

Sketch of Service Here

15

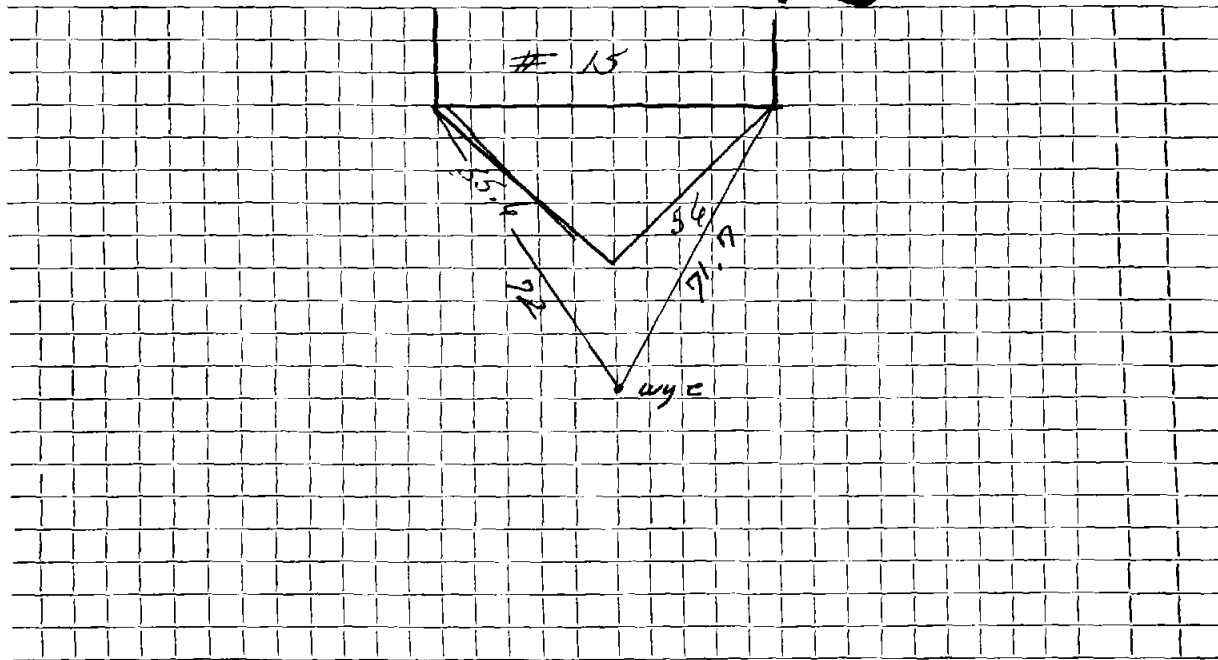

Connection made in ..... Street. Work completed .....

Remarks: .....  
.....  
.....