

Name John L. Tagen

Service No. 153

Address 17 Diamond Road

Location

Kind of Pipe

Size

Size of Main

~~Repair/ Renewal~~ New Service W.O. #7619


Location *Comm 10-29-62*

Date	Material	Amount	Total	Date	Amount	
9-8-62	Labor	83.74		9-20-62	Deposit	125.00
	10 % O.H.	8.37	92.11			67.41
	115' 6" Transite pipe @82		94.30			192.41
	2 Hrs. Trucking @3.00		6.00			
			192.41			

DATE \_\_\_\_\_

TOWN OF LEXINGTON — BOARD OF PUBLIC WORKS  
SEWER DIVISION

Sketch of Service Here **17**

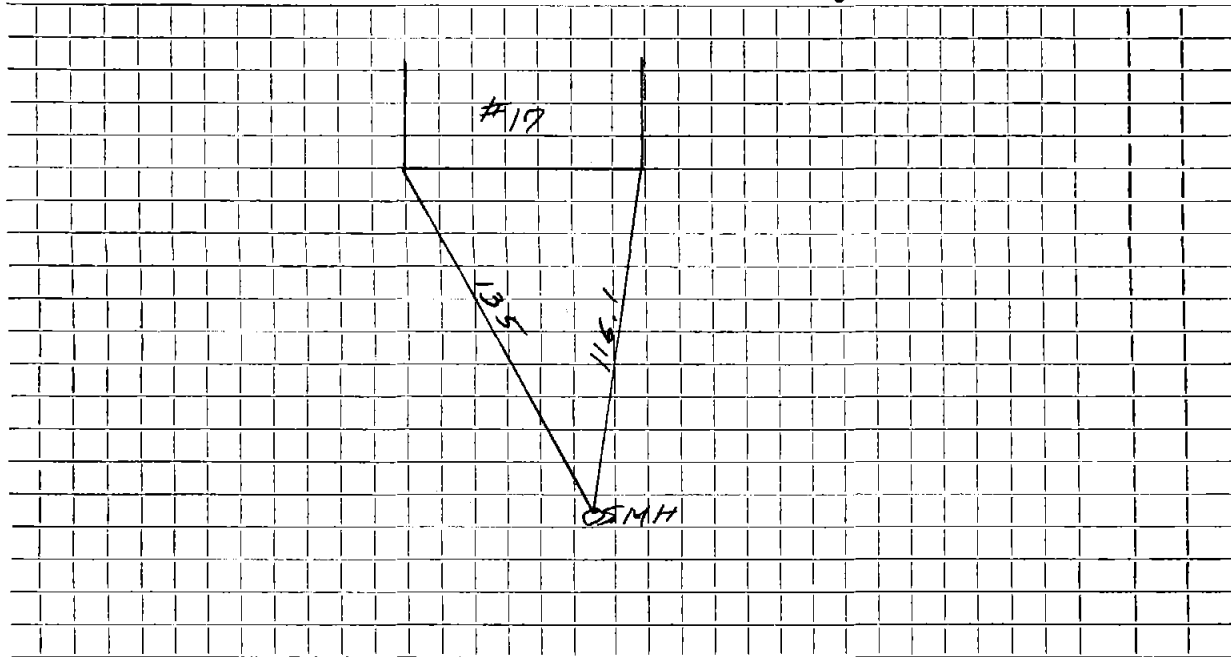

Connection made in ..... Street. Work completed .....

Remarks: .....  
.....  
.....