

Name Benjamin Franklin Homes, Inc.

Service No. 131

Address 18 Diamond Road

Location

Kind of Pipe

Size

Size of Main

~~Repair~~ ~~Renew~~ ~~Work~~ — New Service W.O. #7536

Location *Camden 10-29-62*


Date	Material	Amount	Total	Date	Amount
9-14-62	Labor	13.34		8-13-62	125.00
9-17-62	"	82.13	95.47	10-29-62	38.25
	10% O.H.	9.55	105.02	11-5-62	36.31
	98' 6" Transite pipe @82		80.36		199.56
	2 11 1/4" Transite Bend @4.09		8.18		
	2 Hrs. Trucking @3.00		6.00		
			199.56		

DATE _____

TOWN OF LEXINGTON — BOARD OF PUBLIC WORKS
SEWER DIVISION

Sketch of Service Here

18

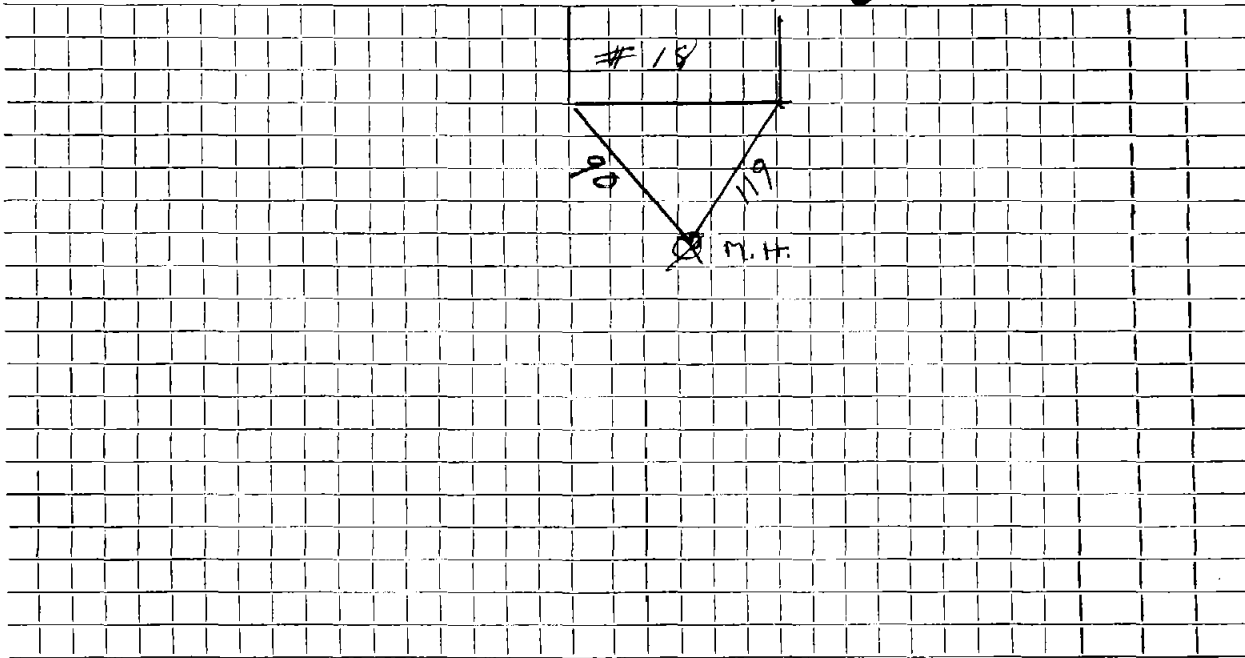

Connection made in Street. Work completed

Remarks:

.....

.....