

Name Ben Franklin Homes

Service No. 10

Address 3 Diamond Road

Location

Kind of Pipe Lat # 1 Sta 3+24

Size

Size of Main

~~Repair~~ ~~Renewal~~ New Service W.O.# 7512

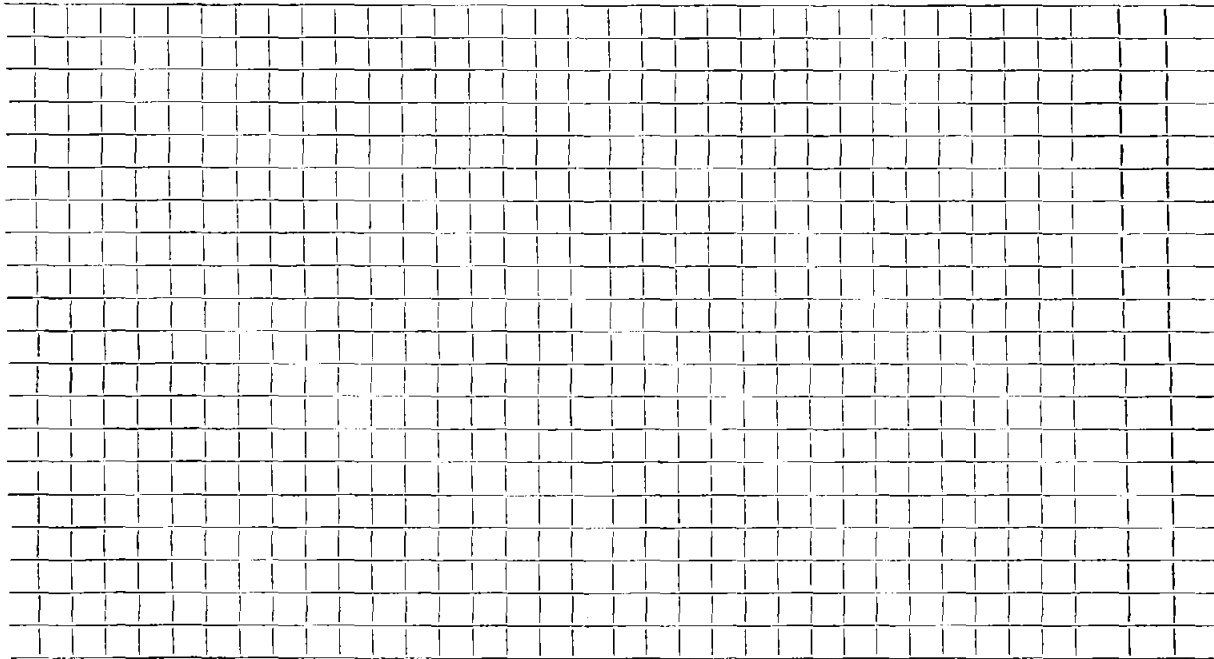
Location Corner 8-26-63

Date	Material	Amount	Total	Date	Amount
9-13-62	Labor	72.01		4-3-63	Deposit 156.00
	10% O.H.	7.20	79.21	8-26-63	Paid by SH #216 22.10
	33' 6" Transite pipe @.82		27.06		172.10
	1 6" Duplex Adapter		1.62		
	2 hrs. Trucking @3.00		6.00		
	BILL WHEN CONNECTED		113.39		
	66' 6" Transite pipe @.82		54.12		
	1 22 <sup>1</sup> / <sub>2</sub> " Transite Bend		4.09		
			172.10		

DATE \_\_\_\_\_

**TOWN OF LEXINGTON — BOARD OF PUBLIC WORKS**  
**SEWER DIVISION**

Sketch of Service Here

A large grid of graph paper, consisting of approximately 20 columns and 20 rows of small squares, intended for sketching service details.

Connection made in ..... Street.                      Work completed .....

Remarks: .....  
.....  
.....