

Name Benjamin Franklin Homes

Service No. 149

Address 5 Diamond Road

Location

Kind of Pipe Lot #2 Sta 5+10

Size

Size of Main

~~Repair~~ ~~Renewal~~ — New Service

Location 4-28-63


Date	Material	Amount	Total	Date	Amount
3-20-62	Labor	43.79		9-17-62	125.00
	10% O.H.	4.38	48.17	4-22-63	2.12
90'	6" Transite pipe @.82		73.80	4-25-63	4.20
1	11 1/4" Transite Elbow		2.35		131.32
1	hr. Trucking @3.00		3.00		
4	hrs. Pumping @1.00		4.00		
			131.32		

DATE _____

TOWN OF LEXINGTON — BOARD OF PUBLIC WORKS
SEWER DIVISION

Sketch of Service Here

5

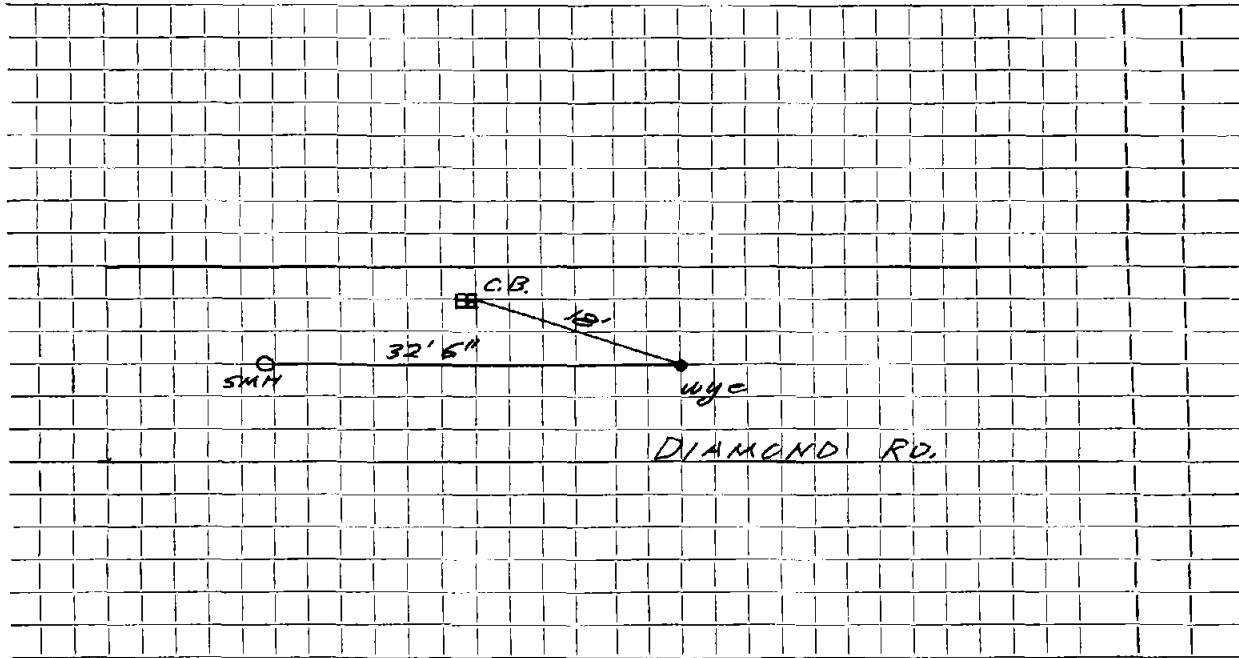

Connection made in Street. Work completed

Remarks:

.....

.....