

Name Benjamin Franklin Homes

Service No. 56

Address 7 Diamond Road

Location

Kind of Pipe Lot #3 Sta 6+25

Size

Size of Main

~~Service Renewal~~ New Service

Location Comm - 10-28-63


Date	Material	Amount	Total	Date	Amount
9-19-62	Labor 94.73			5-28-63	150 60
9-20-62	" 4.22	98.95		10-28-63	70
	10% O.H.	9.90	108.85	10-28-63	10 39
	50' 6" Transite pipe @.82		41.00	10-28-63	83 07
	2 hrs. Trucking @3.00		6.00	11-8-63	102 43
	6 hrs. Pumping @1.00		6.00		346 59
	BILL WHEN CONNECTED		161.85		
6-5-63	Labor	49.75			
	10% O.H.	4.98	54.73		
	95' 6" Transite pipe @.82		77.90		
	2 22 1/2° Transite Bends @4.09		8.18		
	17 1/2 ton 1 1/2" Trone @1.50		26.25		
	2 11 1/4° Transite Bend @4.09		8.18		
	1 hr. Town Shovel @6.50		6.50		
	1 hr. Trucking @3.00		3.00		
			346.59		

DATE _____

TOWN OF LEXINGTON — BOARD OF PUBLIC WORKS
SEWER DIVISION

Sketch of Service Here

7

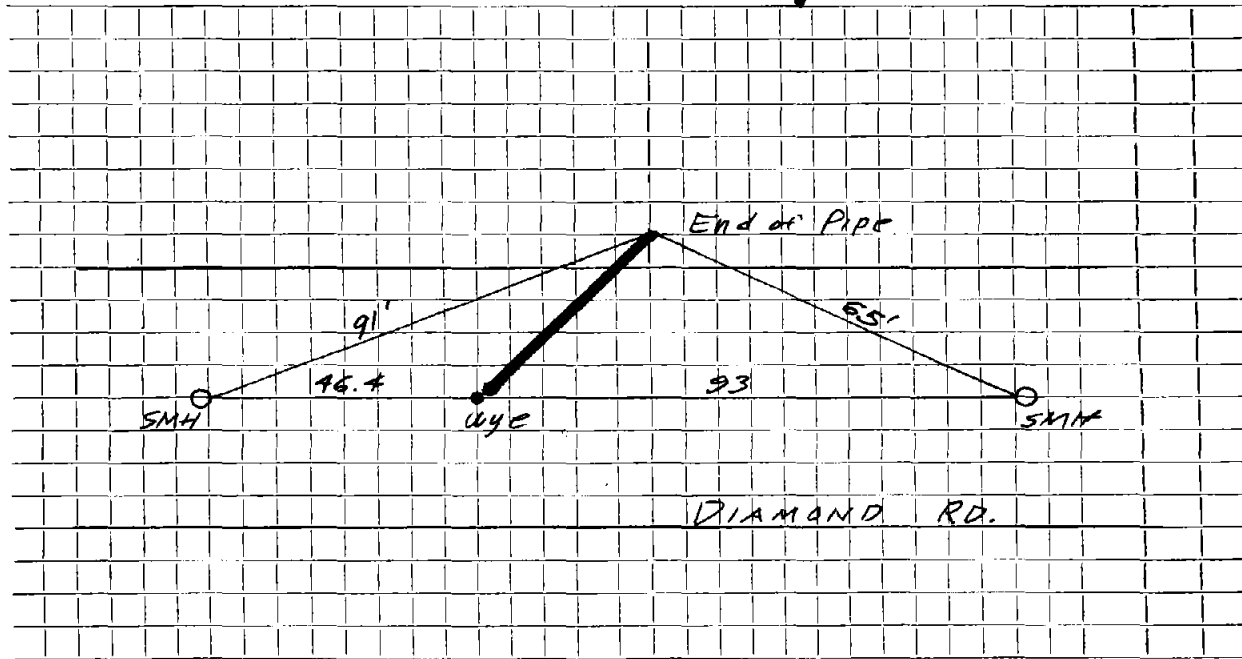

Connection made in Street. Work completed

Remarks:
.....
.....