

Name Benjamin Franklin Homes

Service No. 57

Address 8 Diamond Road

Location

Kind of Pipe Lot # 10 Sta 6735

Size

Size of Main

~~Repair~~ ~~Renewal~~ — New Service WO# 7488

Location Comm 10-28-63

Date	Material	Amount	Total	Date	Amount
9-20-62	Labor	52.27		5-24-63	150.00
	10% O.H.	5.23	57.50	11-8-63	55.84
	30' 6" Transite pipe @.82		24.60		<u>205.84</u>
	1 hr. Trucking @3.00		3.00		
	5 hrs. Pumping @1.00		<u>5.00</u>		
	BILL WHEN CONNECTED		90.10		
6-5-63	Labor	39.76			
	10% O.H.	3.98	43.74		
	50' 6" Transite pipe @.82		41.00		
	1 6" Duplex Adapter		1.62		
	11 1/2 ton 1 1/2" Stone @1.50		16.88		
	2 hrs. Town Truck @3.00		6.00		
	1 hr. Town Shovel @6.50		<u>6.50</u>		
			205.84		


DATE _____

TOWN OF LEXINGTON — BOARD OF PUBLIC WORKS

SEWER DIVISION

Sketch of Service Here

8

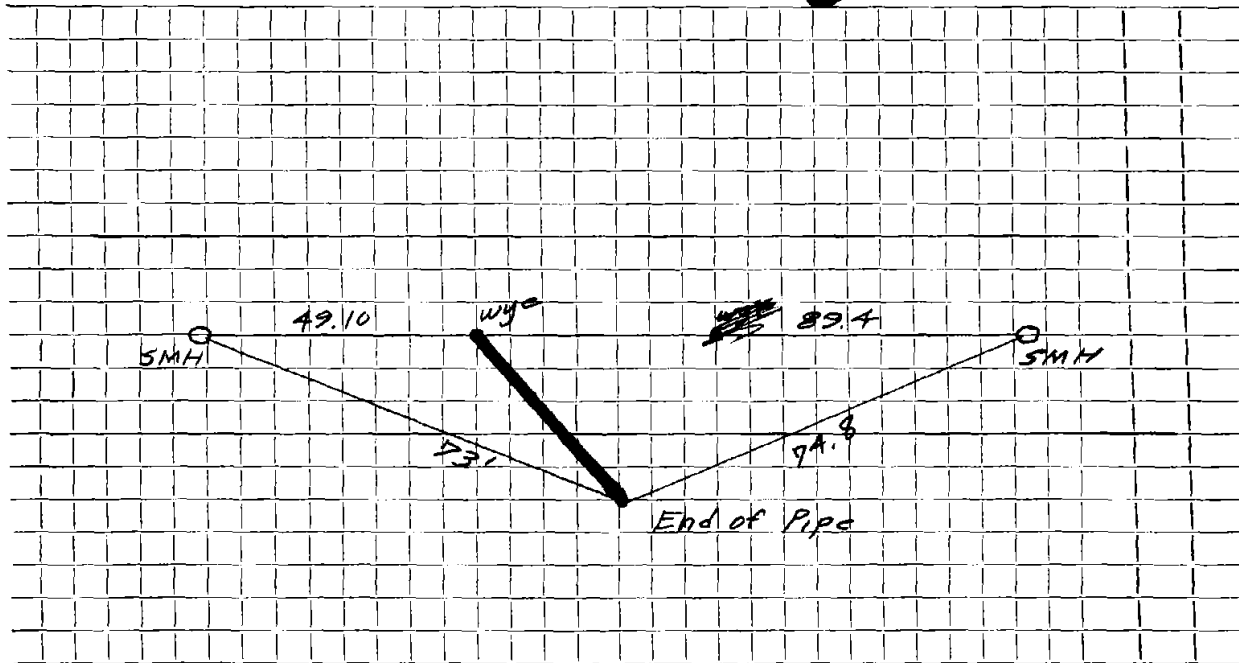

Connection made in Street. Work completed

Remarks:
.....
.....