

Name Benjamin Franklin Homes

Service No. 150

Address 9 Diamond Road

Lot #4 Sta 7+91

Location

Kind of Pipe

Size

Size of Main

~~Repair/ Renewal~~ — New Service W.O. #7604


Location Comm 10-29-62

Date	Material	Amount	Total	Date	Amount
9-21-62	Labor 29.66			9-17-62	Deposit 125.60
9-24-62	" 2.48	31.14			96
	10% O.H.	3.81	41.95		125.90
	89' 6" Transite pipe @.82		73.98		
	1 6" 11 1/2" Transite Elbow		2.35		
	1 6" Duplex Adapter		1.62		
	1 hr. Trucking @3.00		3.00		
	4 hrs. Pumping @1.00		4.00		
			125.90		

DATE _____

TOWN OF LEXINGTON — BOARD OF PUBLIC WORKS
SEWER DIVISION

Sketch of Service Here **9**

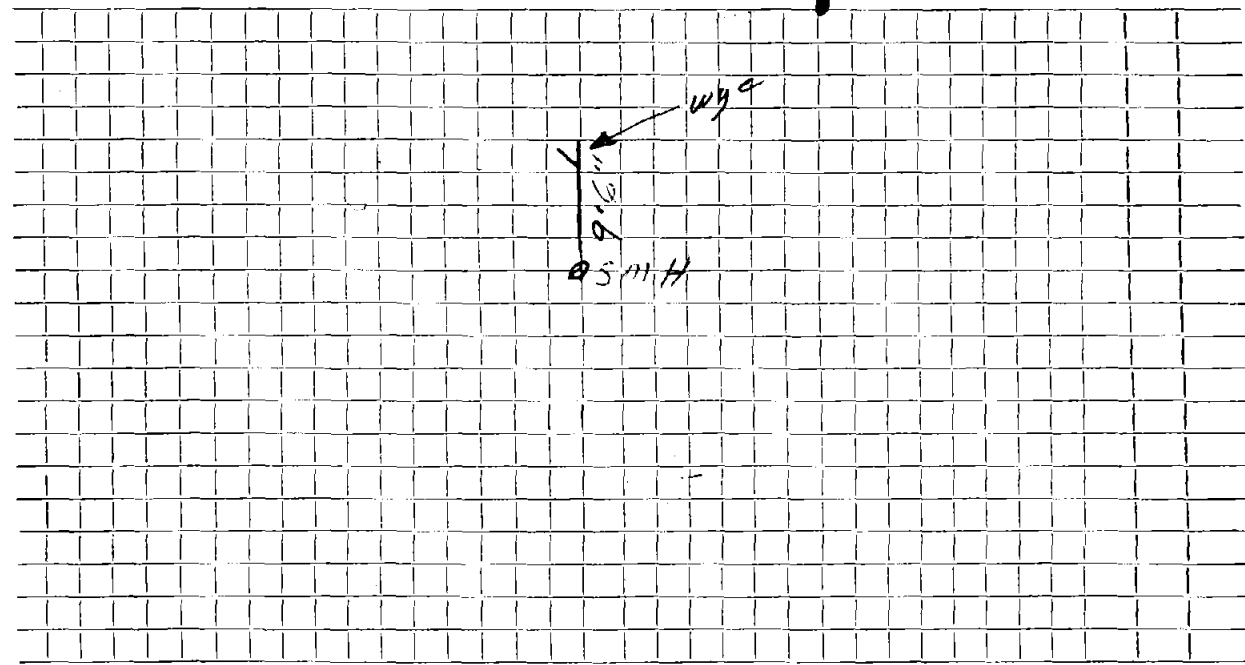

Connection made in Street. Work completed

Remarks:
.....
.....