

Name Lloyd Baylis

Service No. 21

Address 17 Diana Lane

Location

Kind of Pipe

Size

Size of Main

~~Repair or Renewal~~ New Service

Location

Date	Material	Amount	Total	Date	Amount
4/4/56	Labor	15 60		3-29-56 Deposited	250 00
	"	20 63		8-6-56 Refund	108 86
		36 23			141 14
	10% overhead	3 62	39 85		
	90' - 6" Sewer Pipe @ .3645		32 81		
	Joint compound		5 40		
	7 1/3 hrs. Littlefield Shovel	18.50	62 33		
	1 hr. trucking		75		
			141 14		
	Labor				

TOWN OF LEXINGTON—DEPT. OF PUBLIC WORKS
SEWER DIVISION

DATE

NO.


The undersigned applies for the construction of a particular sewer connecting No.....
Street and hereby agrees to comply with the Rules and Regulations governing the construction and use of Particular
Sewers, as now or at any future time established by the Board of Selectmen.

Am't of estimate \$.....

Am't Paid \$.....

..... Owner

Sketch of Service Here

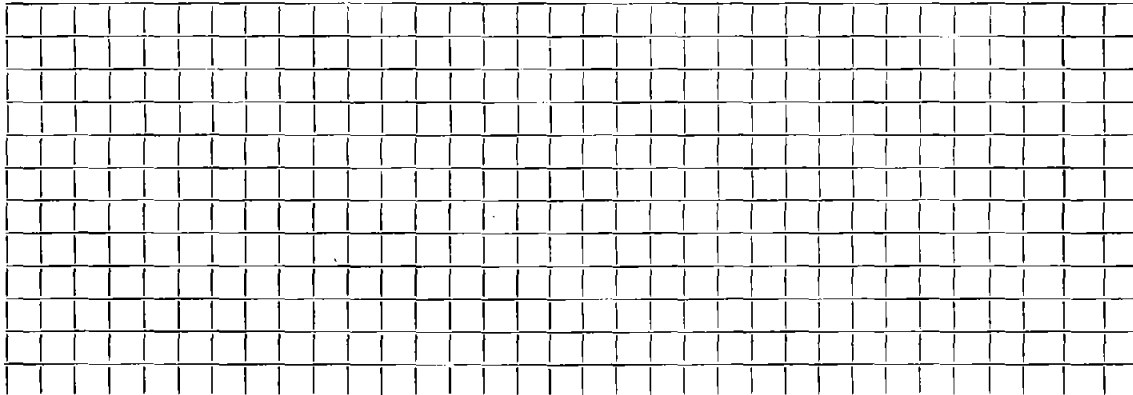

Connection made in..... Street.

Work completed.....19..

Remarks: