


TOWN OF LEXINGTON — BOARD OF PUBLIC WORKS  
SEWER DIVISION

DATE 2/4/2021

Sketch of Service Here

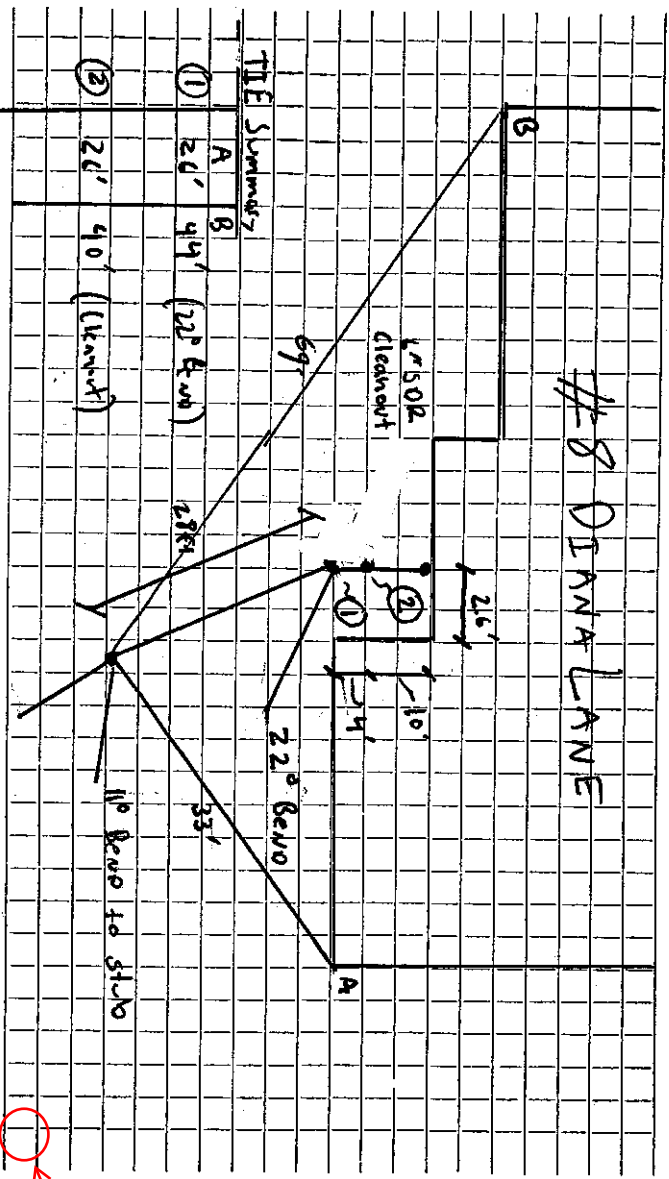

THE SUMMARY

	A	B
(1)	20'	44' (22' E.M.)
(2)	20'	40' (11' BANK)

SMH  
BM: 110.61'

Connection made in DINKA Street. Work completed

Remarks: Elevations: B.M. = Sewer MH = 110.61

House = 105.5 ft ft

Connection (slu) = 103.5 ft



Name Anthony Sperduto

Service No. 19

Address 8 Diana Lane

Lot #2A

Location

Kind of Pipe

Size

Size of Main

Repair—Renewal—New Service

Trebino #1565

Location JUL 27 1970

Date	Material	Amount	Total	Date	Amount
<del>4-16-69</del>	<del>18' 6" Transite pipe</del>	<del>@9.00</del>	<del>162.00</del>	<del>4-29-70</del>	<del>162.00</del>
5-4-70	29' 6" Transite pipe				
	10' 4" Cast Iron pipe				
				11- - 69	
				18' 6" Transite	

DATE \_\_\_\_\_

TOWN OF LEXINGTON — BOARD OF PUBLIC WORKS  
SEWER DIVISION

Sketch of Service Here

8

