

Name Stanley Zisk

Service No. 145

Address 9 Diana Lane

Lot A3 & B4

Location

Lot A3 & B4

Kind of Pipe

Size

Size of Main

Repair—Renewal—New Service Trebino #1518

Location APR 6 1970

Date	Material	Amount	Total	Date	Amount
Nov '69	27' 6" Transite pipe @9.00		243.00	12-2-69	Deposit 243.00
12-11-69	44' 6" Transite pipe			JUL 27 1970	Refund 27.00
	3' 4" Cast Iron pipe				(see other card) 216.00
				12- -69	
				24'	6" Transite


DATE \_\_\_\_\_

TOWN OF LEXINGTON — BOARD OF PUBLIC WORKS

SEWER DIVISION

Sketch of Service Here

9

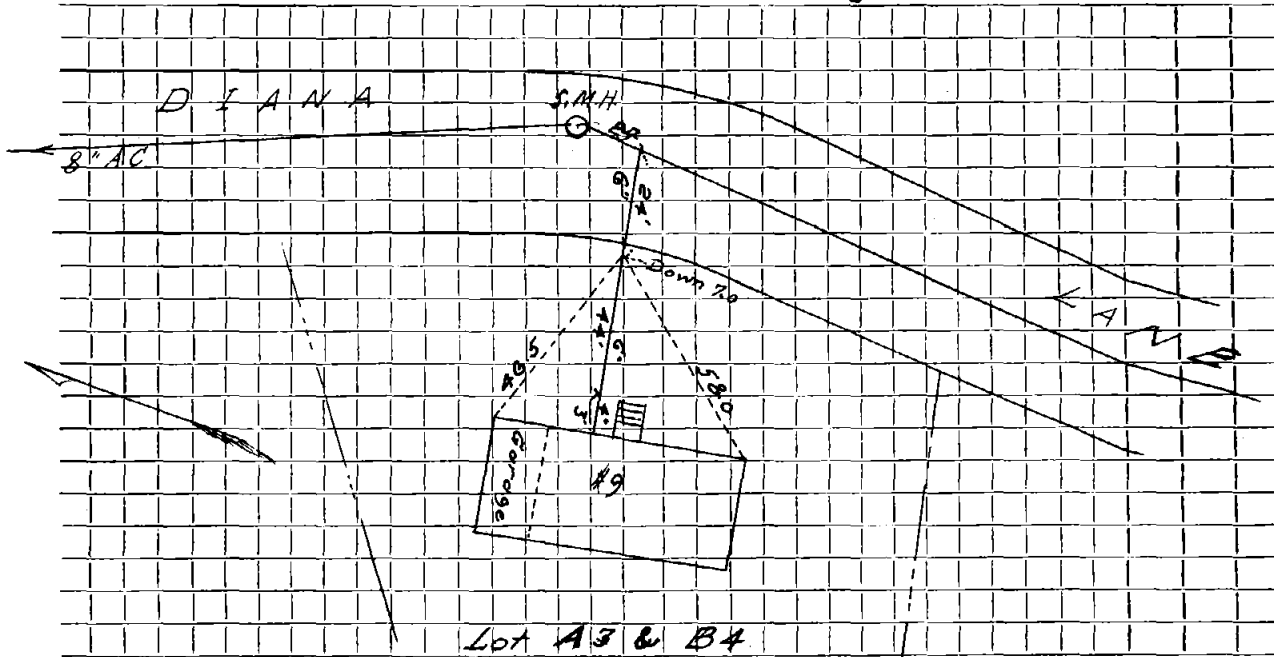

Connection made in ..... Street. Work completed .....

Remarks: .....

.....

.....