

Name

Service No.

Address

Diana Lane

Vacant Lot #2

Location

Kind of Pipe

Size

Size of Main

Repair—Renewal—New Service


Location

Date		Material	Amount	Total	Date	Amount
10-20-69	18"	6" Transite pipe @9.00		162.00		

DATE 10-20-69

TOWN OF LEXINGTON — BOARD OF PUBLIC WORKS
SEWER DIVISION

Sketch of Service Here
Vacant Lot # 2

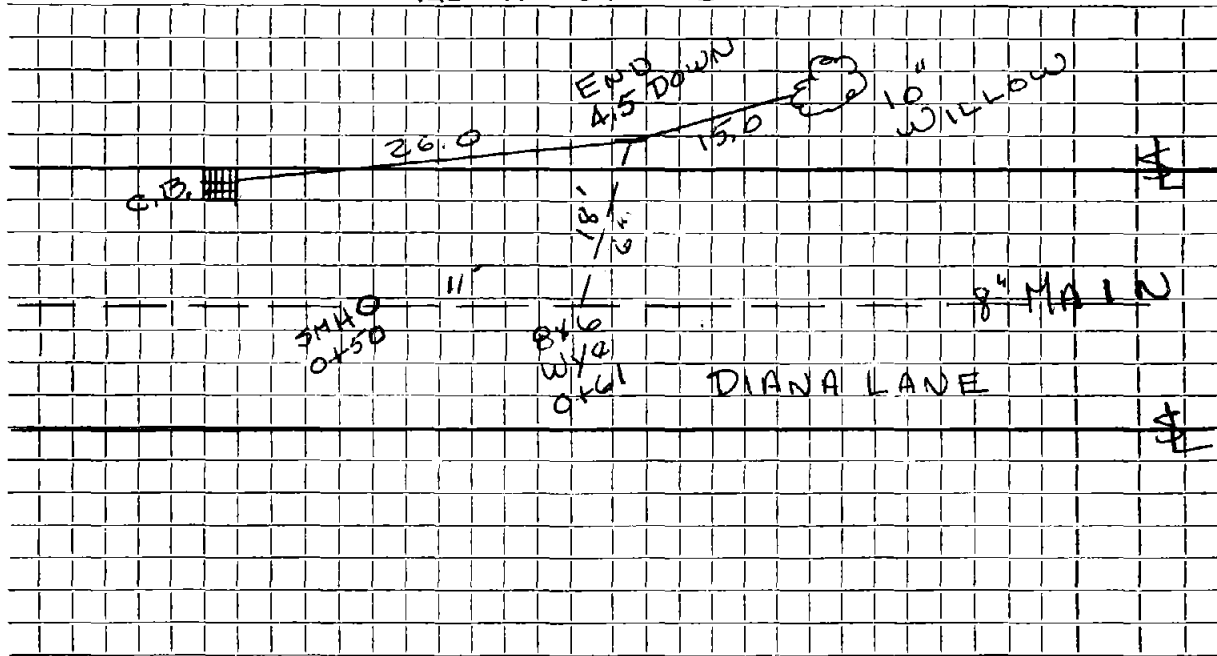

Connection made in Street. Work completed

Remarks:
.....
.....