

Name

Service No. 2569

Address

6 Diehl Rd

Location

LOT 89

Kind of Pipe

PVC

Size

Size of Main

Repair—Renewal—New Service

J McLaughlin

Location

Date

Material

Amount

Total

Date

Amount

8/22/07

6'
60'

4" PVC
6" PVC

? → 6" AC x 6" PVC Fences

1 4x6 Fence


8/27/54

old card shows Clay Pipe

DATE _____

TOWN OF LEXINGTON — BOARD OF PUBLIC WORKS
SEWER DIVISION

Sketch of Service Here

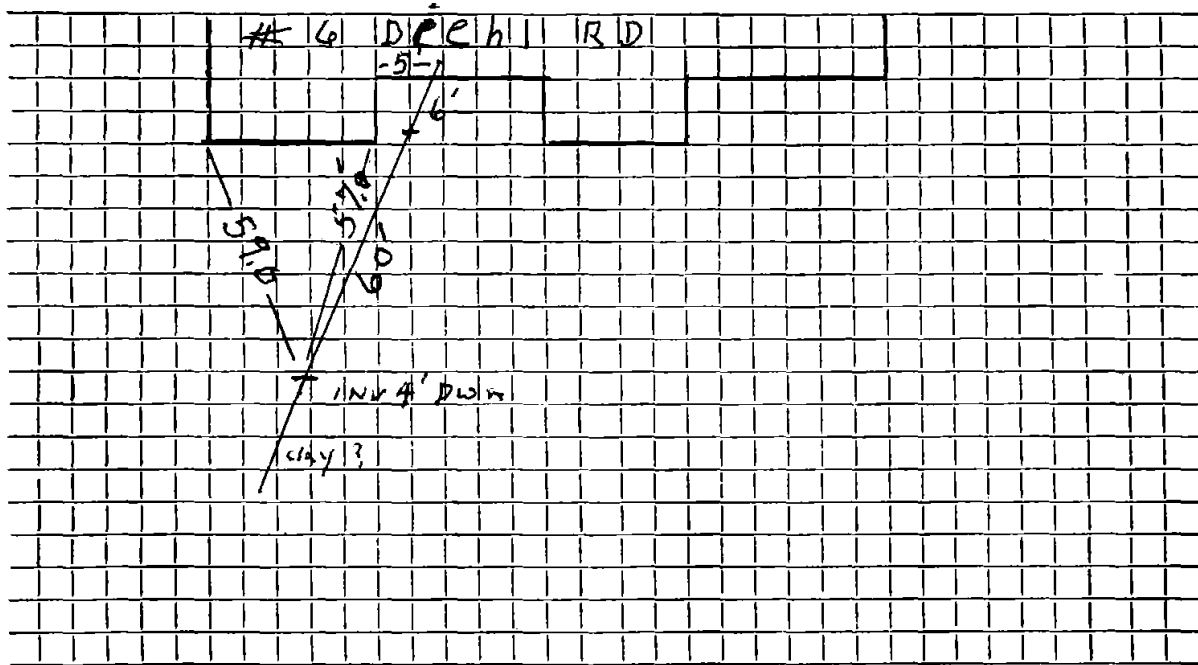

Connection made in Street.

Work completed 8/22/07 J. Melanogklim.....

Remarks:
.....
.....