
Name	Mark Moore, Jr.							Service No	. 36	
Addres	s 8 Dienl Rd.									
·			<u>.                                    </u>			Location			· · · · · · · · · · · · · · · · · · ·	
Kind o	Kind of Pipe		Size			Size of Main				
Ropaix:	Repair XXRenewal New Service		com.		6-1-54		Location			
Date Material		Amount		Total		Date			Amount	
/18/54	Labor	33	73			تو- 0 بی حق	1 2	postod Sunded	1500	0
	10% Overhead	3	37	3 <b>7</b>	10	6-1-5	4 /12	huded	25 8	P
	76' - 6" sewer p	ipe@.3087	7	23	46				1241	
	joint_compound			4	56					
	7 2/3 hrs.Little	field sho	vel	57_5	<b>5</b> 0					
	2 hrs. trucking	<b>@.</b> 75		1	50					
				124	12					
										_
								•		
	Labor									
-										
				<u>-</u>						
HP-9694							_			4

## TOWN OF LEXINGTON—DEPT. OF PUBLIC WORKS SEWER DIVISION

DATE	NO
The undersigned applies for the construction of a particular sewer connecting No	· · · · · · · · · · · · · · · · · · ·
Street and hereby agrees to comply with the Rules and Regulations governing the construction and	use of Parti <b>cular</b>
Sewers, as now or at any future time established by the Board of Selectmen.	
Am't of estimate \$	
Am't Paid \$	
	Owner

## Sketch of Service Here

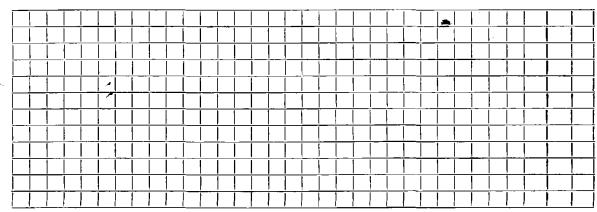

Connection made in	Street.	Work completed	19.

Remarks: