


TOWN OF LEXINGTON — BOARD OF PUBLIC WORKS
SEWER DIVISION

DATE

4/26/21

#3 STICA 11' 6"
4' clearances
11' 0" Bend Sketch of Service Here

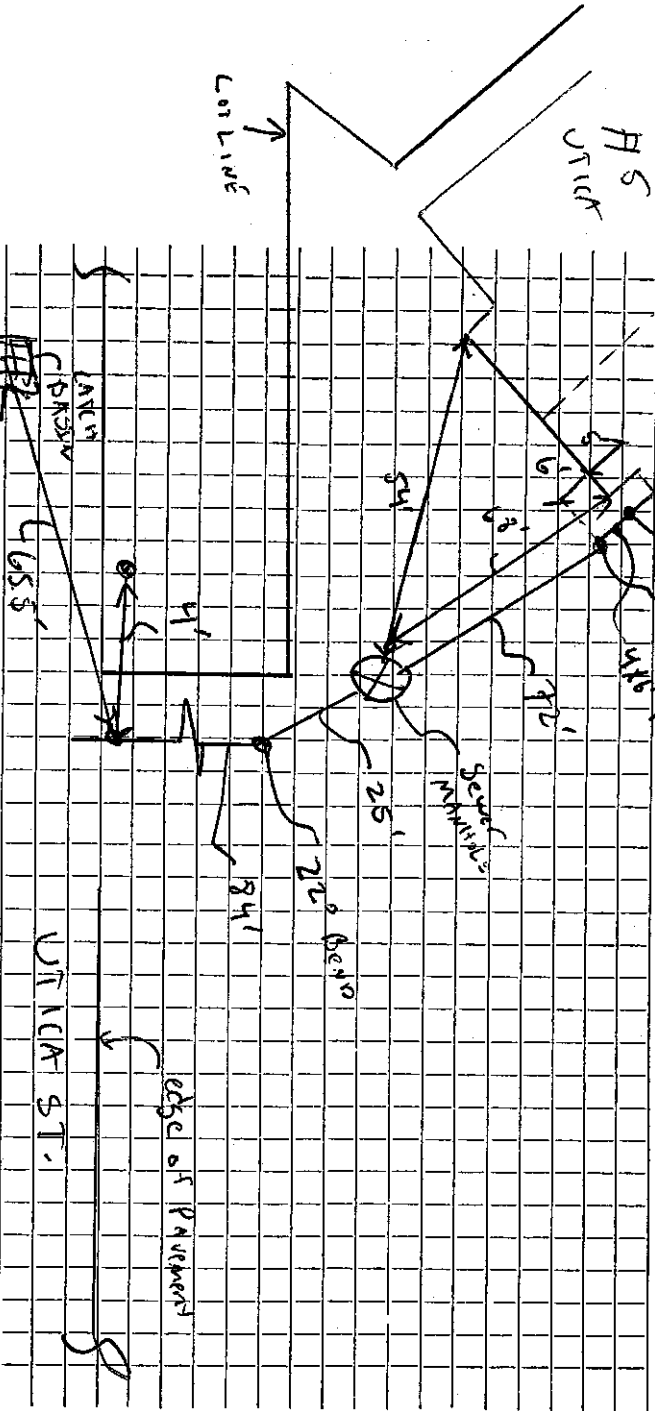

Connection made in UTICA Street Work completed Fenwick

Remarks:

Name J. McLayhlin Inc.

Service No. Wwz122

Address 3 UTICA ST

Location

Kind of Pipe SOR-35 Size 6 Size of Main 8

Repair ~~Renewal~~ - New Service

Location

Date	Material	Amount	Total	Date	Material	Amount
4/26/21	ROAD → HOUSE				SOR-35-6"	6'
	6x8 Service	0			4x6" Ferroc	①
	SOR-35 6"	87ft			4" PVC	2'
	6" 22° Bend	①			4" clearest	0
	SOR-35 6"	25ft			4" PVC	5'
	MANHOLE	0				
	SOR-35 6"	68ft				
	6" 11° Bend	①				