

Name William H. Sullivan

Service No. 13

Address 12 Donald Street

Location

Kind of Pipe

Size

Size of Main

Repair—Renewal—New Service

Location

Date		Material		Amount		Total		Date		Amount	
4/25/56		Labor		86 77				3-1-56		Deposited	
		10% overhead		8 68		95 45		8-20-56		Paid	
		52' 6" Sewer Pipe @ .3645				18 95				154 27	
		Joint Compound				3 12					
		4 hrs. Town Shovel @ 6.00				24 00					
		1 hr. trucking @ .75				75					
		20 yds. Bank Gravel @ .60				12 00					
						154 27					
		<b>Labor</b>									

**TOWN OF LEXINGTON—DEPT. OF PUBLIC WORKS  
SEWER DIVISION**

DATE.....

NO. ....


The undersigned applies for the construction of a particular sewer connecting No. ....  
Street and hereby agrees to comply with the Rules and Regulations governing the construction and use of Particular  
Sewers, as now or at any future time established by the Board of Selectmen.

Am't of estimate \$.....

Am't Paid \$.....

..... Owner

**Sketch of Service Here**

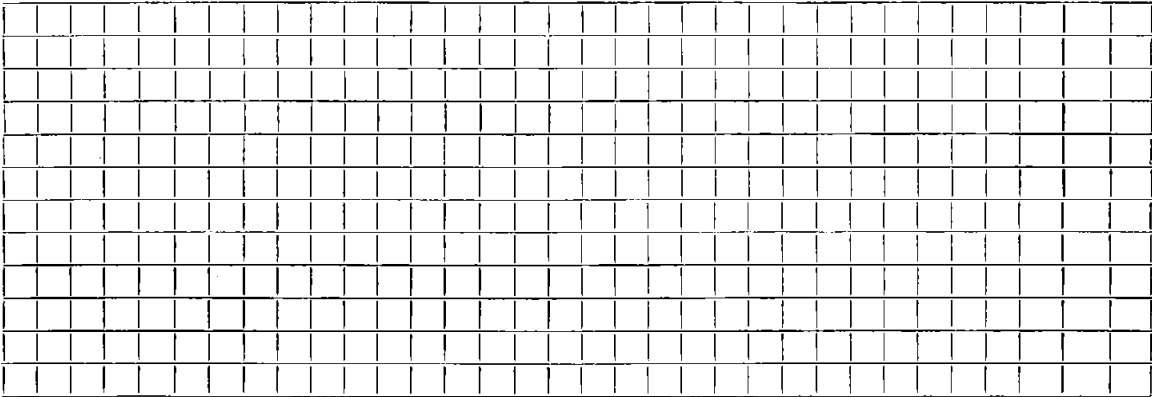

Connection made in ..... Street.

Work completed.....19..

Remarks: