

Name Elliott J. Barrett

Service No. 111

Address 1st Donald St.

Lexington

Location

Kind of Pipe

Size

Size of Main

~~Repair~~ ~~Renewal~~ ~~X~~ New Service

COM. 7-13-53

Location

Date	Material	Amount	Total	Date	Amount
6/19/53	Labor	54 40		6-5-53	125 00
	10% overhead	5 44	59 84	7-13-53	(22 48)
	48'-6" Sewer Pipe @.342		16 42		102 52
	1-6" Elbow		1 88		
	Joint Compound		2 88		
	1 Hr. Town Shovel @5.00		20 00		
	2 Hr. Trucking @.75		1 50	11-22-95	RESPOND + Measure
			102 52		
	Labor				

**TOWN OF LEXINGTON—DEPT. OF PUBLIC WORKS
SEWER DIVISION**

DATE.....

NO.....


The undersigned applies for the construction of a particular sewer connecting No.....
Street and hereby agrees to comply with the Rules and Regulations governing the construction and use of Particular
Sewers, as now or at any future time established by the Board of Selectmen.

Am't of estimate \$.....

Am't Paid \$.....

..... Owner

Sketch of Service Here

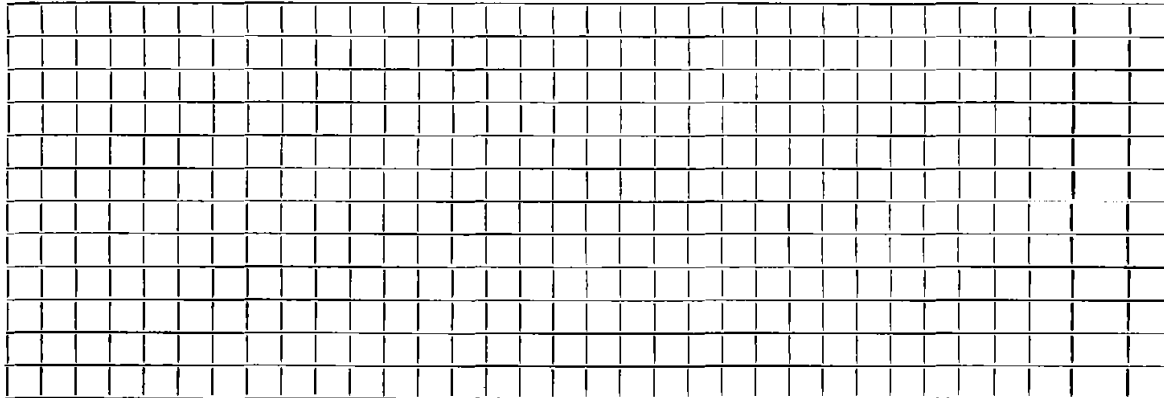

Connection made in..... Street.

Work completed.....19..

Remarks: