


DATE 3-9-12

TOWN OF LEXINGTON — BOARD OF PUBLIC WORKS
SEWER DIVISION

Sketch of Service Here

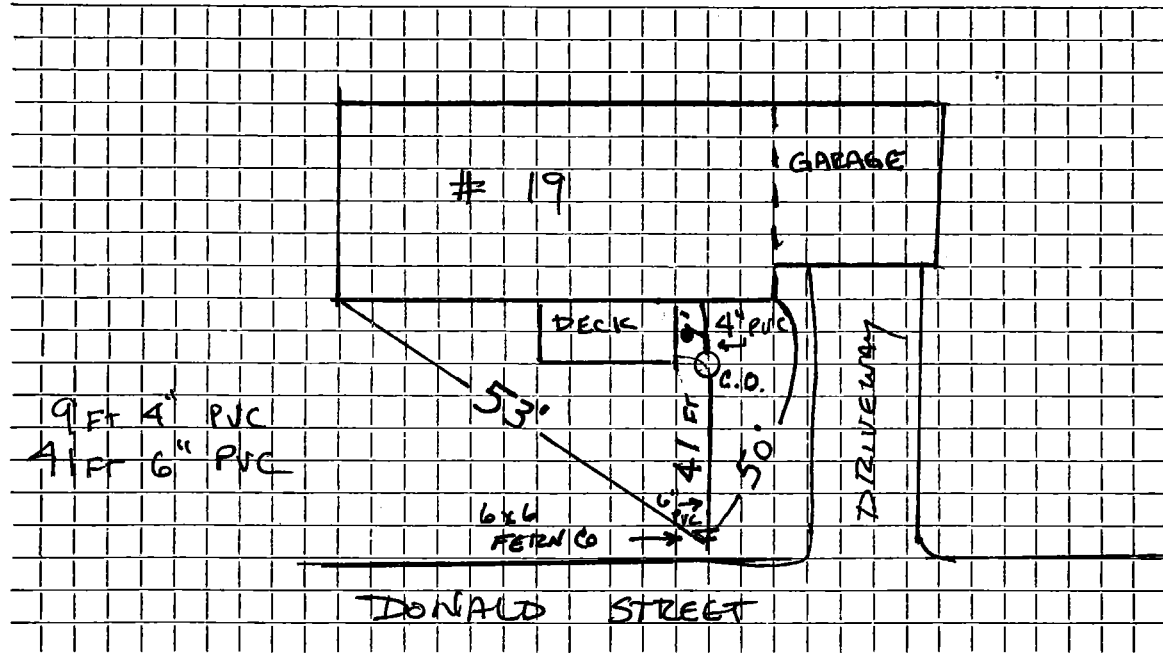

Connection made in Street. Work completed

Remarks: DEPTH. AT CLEAR OUT = 4'-6" 9 FT 4" PVC

..... DEPTH. AT 6x6 FERN CO = 5.0 4 FT 6" PVC