


Date: 6/8/23

TOWN OF LEXINGTON - BOARD OF PUBLIC WORKS
SEWER DIVISION

SKETCH OF SERVICE HERE

C = Cleanout
D = 6x4 ferro
E = 6x6 ferro
AC = 15'
AD = 15'5"
AE = 36'4"
BC = 2'3"
BD = 2'11"
BE = 27'5"

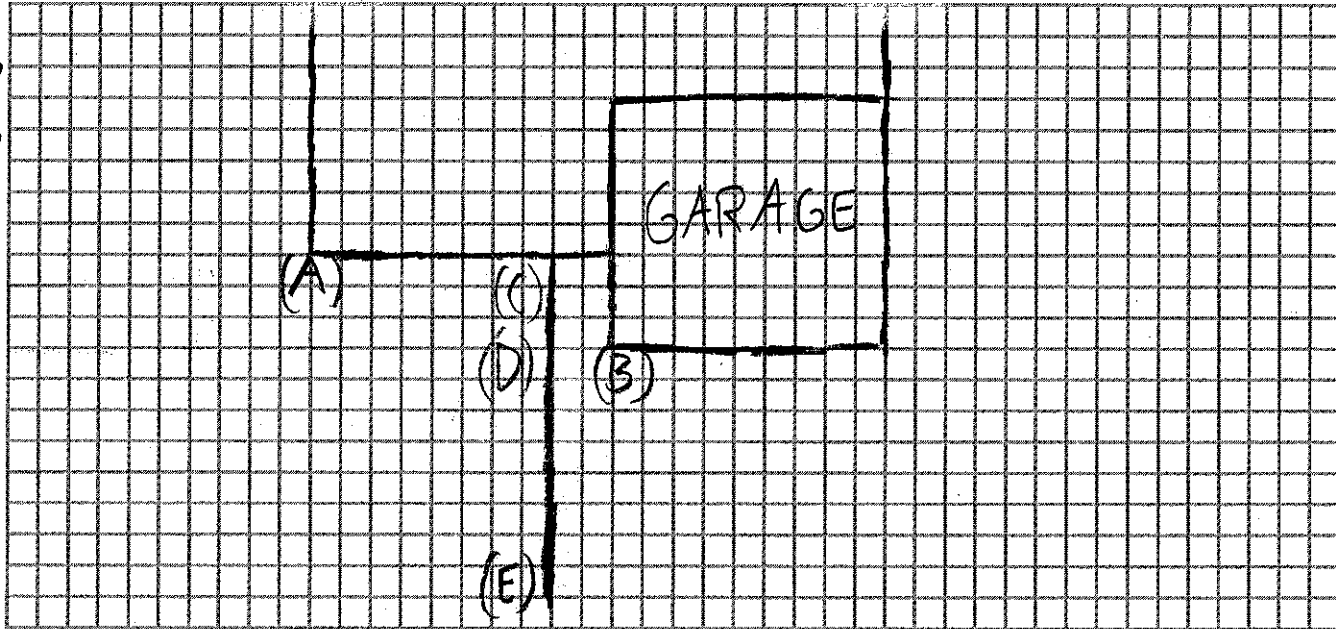

Connection made in: 24 Donald Rd Street. Work completed: by Bradley Co

Remarks: