

Name Joseph Zagami

Service No. 133

Address 30 Donald Street

Location

Kind of Pipe

Size

Size of Main

~~Repair~~ ~~Renewal~~ - New Service

COM. 8-10-53

Location

Date	Material	Amount	Total	Date	Amount
7/14/53	Labor	73 21		7-7-53	Deposited 125 00
	10% overhead	7 32	80 53	5-4-54	Paid (11 54
	100' - 6" sewer pipe @ .3036		30 36		136 54
	1 - 6" elbow		1 88		
	1 - 6 x 6 Y		1 27		
	joint compound		6 00		
	3 hrs. town shovel @ 5.00		15 00		
	2 hrs. trucking		1 50		
			136 54		
	Labor				

**TOWN OF LEXINGTON—DEPT. OF PUBLIC WORKS
SEWER DIVISION**

DATE.....

NO.


The undersigned applies for the construction of a particular sewer connecting No.....
Street and hereby agrees to comply with the Rules and Regulations governing the construction and use of Particular
Sewers, as now or at any future time established by the Board of Selectmen.

Am't of estimate \$.....

Am't Paid \$.....

..... Owner

Sketch of Service Here **30**

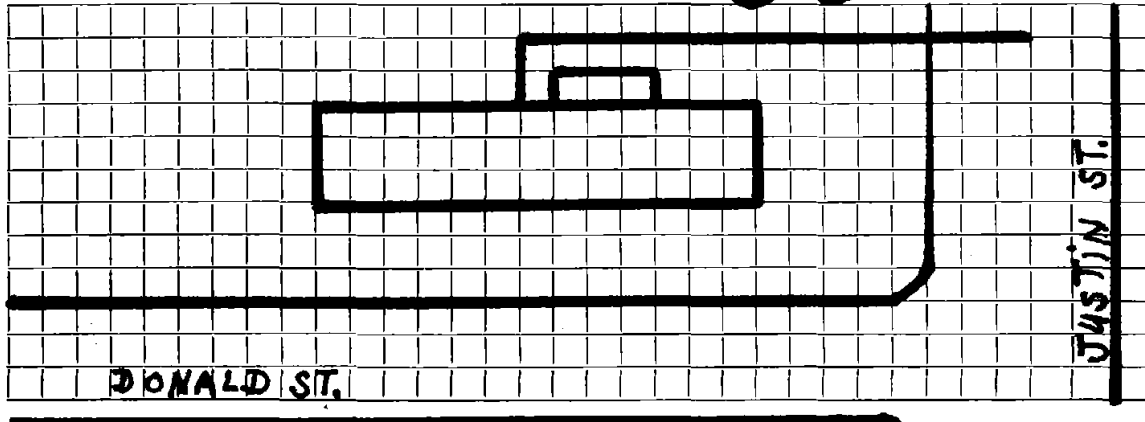

Connection made in..... Street.

Work completed..... 19..

Remarks: