

Name Outhet Realty Trust

Service No. 222

Address # 5 Donald Street

Lot #157

Location Lot 157

Kind of Pipe

Size

Size of Main

Repair—Renewal—New Service

Location *Comm 12-31-59*

Date	Material	Amount	Total	Date	Amount
	34.5' V.C. Pipe @ 3.00		103.50	<i>11-25-59</i>	<i>Deposit 125.00</i>
	Installed by contractor			<i>2-25-60</i>	<i>Paid 13.08</i>
	(Owner to be billed when connected)				<i>188.08</i>
11-3-59	Labor	31.22			
	10% O.H.	3.12	34.34		
	32' 6" Transite pipe @.70		22.40		
	1 1 1/4" Transite Elbow		2.24		
	1 1 1/4" Transite Bend		5.10		
	2 hrs. Town Shovel @6.50		13.00		
	2 hrs. Trucking @.75		1.50		
	1 hr. Trucking @3.00		3.00		
	1 hr. Rogers Trailer @3.00		3.00		
	Labor		188.08		
				<i>13.08</i>	

TOWN OF LEXINGTON—DEPT. OF PUBLIC WORKS

SEWER DIVISION

DATE.....

NO.


The undersigned applies for the construction of a particular sewer connecting No.....
 Street and hereby agrees to comply with the Rules and Regulations governing the construction and use of Particular
 Sewers, as now or at any future time established by the Board of Selectmen.

Am't of estimate \$.....

Am't Paid \$.....

..... Owner

Sketch of Service Here

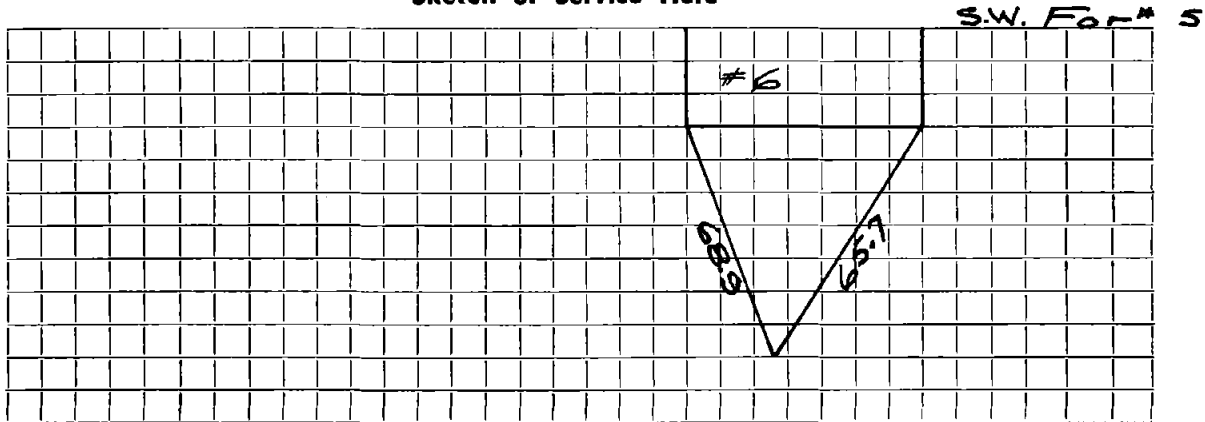

Connection made in..... Street.

Work completed.....19..

Remarks: