

Name

Service No.

Address

10 Douglas Rd

Location

Kind of Pipe

Size

Size of Main

Repair—Renewal—New Service

Location

Date

Material

Amount

Total

Date

Amount

10-25-04


4x6 PVC to PVC Franco
6x6 PVC to AC Franco
39' - 6" PVC
10' - 4" PVC

DATE _____

TOWN OF LEXINGTON — BOARD OF PUBLIC WORKS

SEWER DIVISION

Sketch of Service Here

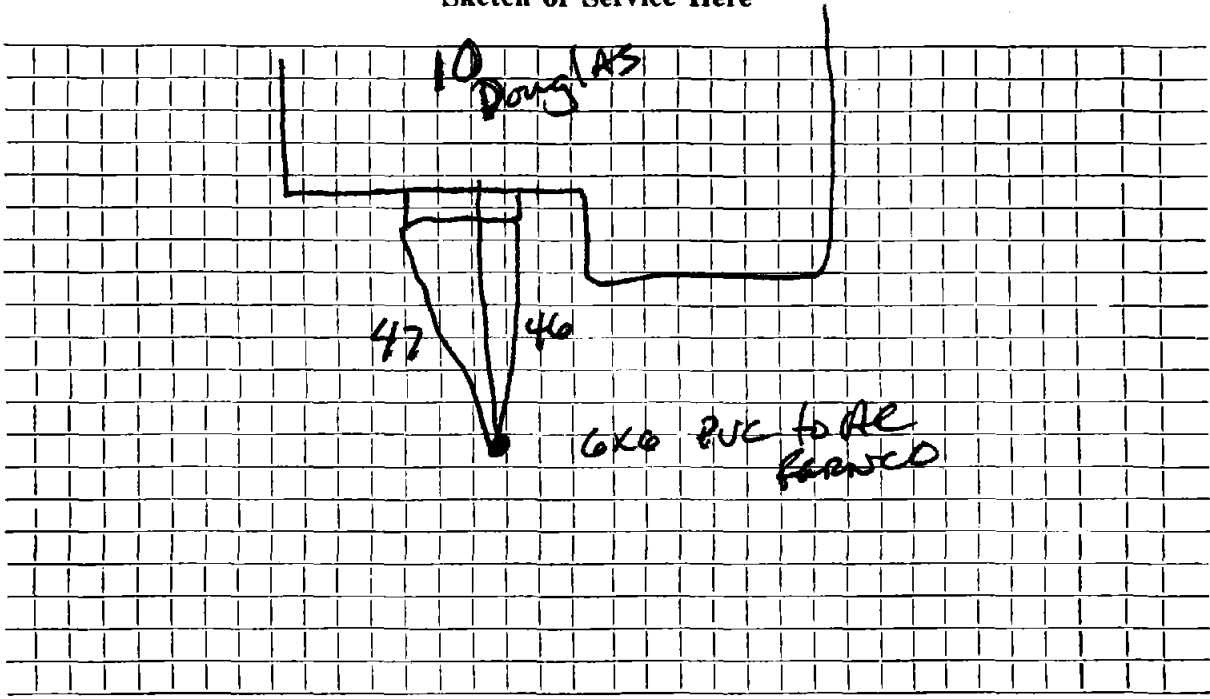

Connection made in Street. Work completed

Remarks:
.....
.....